

KANSAS


Russell

FORM 51 5M 1-42 PETROL

Section 21 Township 15 Range 14-W

Well No. #1 Strecker

Company Ohio Oil etal

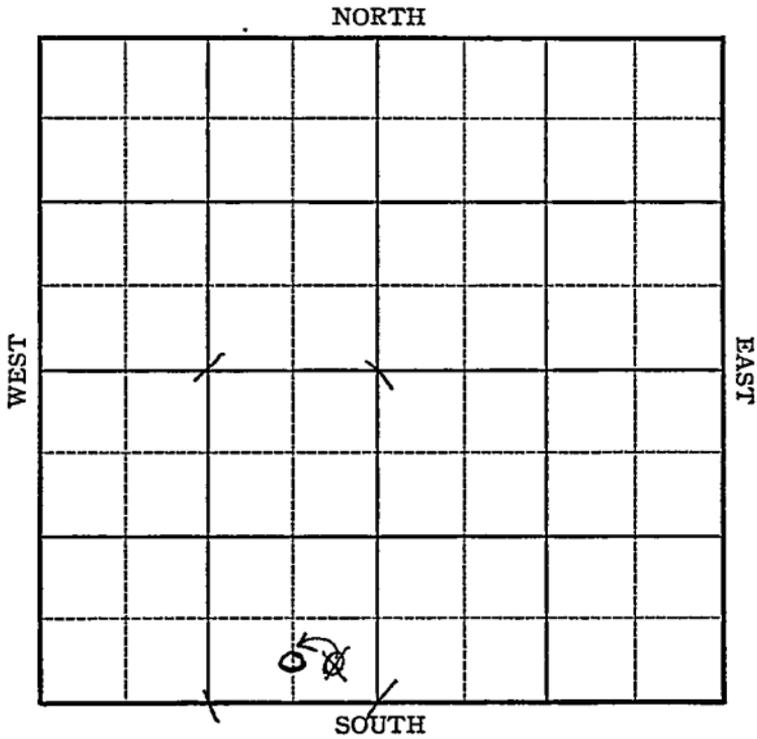

KANSAS

Sec. 21 Twp. 15 R. 14-W

Well No. #1 Strecher Farm

Ohio Oil etal. Company


Wildcat

_____ Ft. from N. Line

330 Ft. from S. Line

660
~~330~~ Ft. from E. Line

_____ Ft. from W. Line

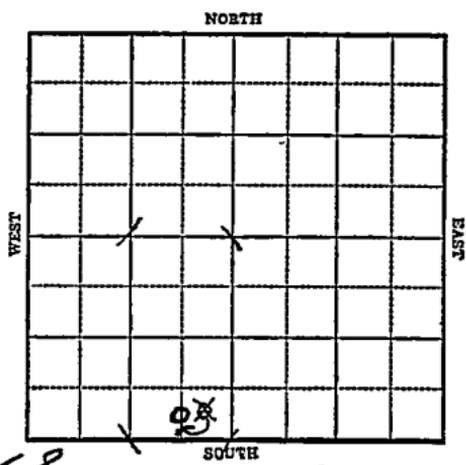

Elec. 1868

1943

R E P O R T

- 4/21 Location.
- 4/28 Rotary
- 5/5 "
- 5/12 8" @ 605'
Anhy 860
- 5/19 Drlg. 2100'
'opela 2789
'ans 3091
Arb 3334
- 5/26 Drlg. 3339 SO
4" @ 3336 RUST.
- 6/2 T.D. 3356 $\frac{1}{2}$
3000 acid 360' oil in 14 hrs.
1000 acid.
- 6/9 Swab 60 oil in 5 hrs.
- 6/16 " " " " "
- 6/23 " " " " "
- 6/30 Arb. -3334
4" @ 3336'
T.D. 3356 $\frac{1}{2}$ '
1300 gal acid
Pump 270 Pot
Gravity 48

COMPLETED

Map No. ~~945~~ **KANSAS** Sec. 21 Twp. 15 R. 14W

Well No. 1 Strecker

Ohio Oil etal. Company

FIRST REPORT Contractor

SE SW


SECTION PLAT

_____ Ft. from N. Line

330 Ft. from S. Line

330 Ft. from E. Line

_____ Ft. from W. Line

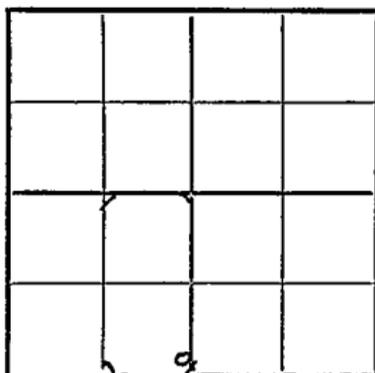

WILDCAT

Location XXX

Rig up _____

Drilling and Remarks:

RECORD

Cased _____ in., _____ ft.

Sand _____

Gas _____

Oil " _____

Total Depth _____

PRODUCTION

1st 24 hrs. Nat. _____

1st 24 hrs. after shot _____

Gas _____ Cu. Ft.

Dry Hole _____

Abandoned _____

Date

APR 21 1943 19

S. J. LEWIS Scout

KANSAS

Russell

Map No. 73 Sec. 21 Twp. 15 R. 14W

Well No. 1 Strecker

Ohio Oil et al. Company

CORRECTION Contractor

C S L S E S W


SECTION PLAT

_____ Ft. from N. Line

330 Ft. from S. Line

660 Ft. from E. Line

_____ Ft. from W. Line

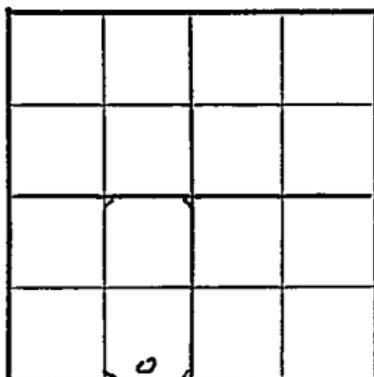

WILDCAT

Location _____

Rig up _____

Drilling and Remarks:

Reported

SE SW

RECORD

Cased _____ in., _____ ft.

Sand _____

Gas _____

Oil _____

Total Depth _____

PRODUCTION

1st 24 hrs. Nat. _____

1st 24 hrs. after shot _____

Gas _____ Cu. Ft.

Dry Hole _____

Abandoned _____

Date

APR 28 1943 19

S. J. LEWIS Scout

Russell

KANSAS

Map No. 73 Sec. 21 Twp. 15 R. 14WWell No. 1 StreckerOhio Oil et al.

Company

COMPLETED

Contractor

C SL SE SW

SECTION PLAT

_____ Ft. from N. Line

330

_____ Ft. from S. Line

660

_____ Ft. from E. Line

_____ Ft. from W. Line

STRECKER POOL

RECORD

Location _____

Cased _____ in., _____ ft.

Rig up _____

Sand _____

Drilling and Remarks:

Gas _____

Oil _____

Total Depth 335 1/2

PRODUCTION

1st 24 hrs. Nat. _____

1st 24 hrs. after shot _____

Gas _____ Cu. Ft.

Dry Hole _____

Abandoned _____

Ce X 33344" @ 33361800 acidPump 270 P & X49 = 92

Date

JUN 30 1943 19S. J. LEWIS Scout