


Map No. K Sec. 35 Twp. 25 R. 13 ✓

Well No. 1 Roles Farm

Altonite oil & Gas Company

(Altonite) - K65
DR NORTH

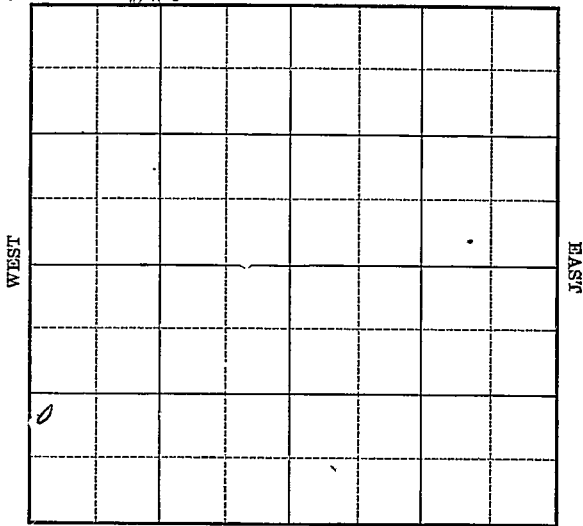

Location _____

Drilling Remarks _____

Rig Up _____

Drilling Remarks _____

RECORD

Cased _____ in. _____ ft.

Sand _____

Gas _____

Oil _____

Total Depth _____

PRODUCTION

1st 24 hrs. Nat. _____

1st 24 hrs. after shot _____

Gas _____ cu. ft.

Dry Hole _____

Abandoned _____

Woodson

Map No. Kansas Sec. 35 Twp. 25 R. 13

Well No. 1 Poles Farm

Atlantic O. & G. Company


Hto MITE of 2 500

_____ Ft. from N. Line

1120 Ft. from S. Line

_____ Ft. from E. Line

200 Ft. from W. Line

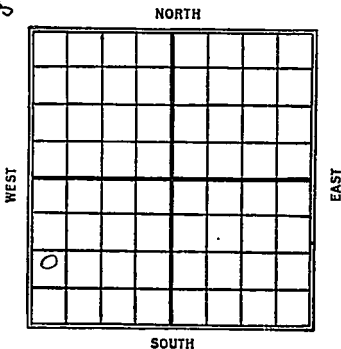

Date

REPORT

Date	REPORT
1926	
6/2	Drilling 1040
6/10	same
6/18	—
6/25	same
6-30	—
7/18	—
7/15	—
7/22	—
8/4	—
8/11	—
8/18	—
8/25	same.
8-31	—
9/15	—
9/22	—
9/29	—
10/3	same
10/27	—
11/3	D. & A. 1531 - I.D. 1531

Woodson
 Map No. KANSAS Sec. 35 Twp. 25 R. 13

Well No. 1 *Loba*
Atomite Oil Co Company

Contractor

FIRST REPORTS

SECTION PLAT

_____ Ft. from N. Line

1120 Ft. from S. Line

_____ Ft. from E. Line

200 Ft. from W. Line

0			

Location _____

Rig up _____

Drilling and Remarks:

Only 1040'

RECORD

Cased _____ in., _____ ft.

Sand _____

Gas _____

Oil _____

Total Depth _____

PRODUCTION

1st 24 hrs. Nat. _____

1st 24 hrs. after shot. _____

Gas _____ Cu. Ft.

Dry Hole _____

Abandoned _____

Date

JUN 2 1926

CHAS. L. SHERWOOD

192

Scout

Map No. *normal* **KANSAS** Sec. *35* Twp. *75* R. *13*

Well No. *Holes*
#Atom 02 & Co Company

Contractor

COMPLETED

SECTION PLAT

_____ Ft. from N. Line

1170 Ft. from S. Line

_____ Ft. from E. Line

200 Ft. from W. Line

<i>0</i>			

ABANDONED

Location _____

Rig up _____

Drilling and Remarks:

DDG
1531

RECORD

Cased _____ in., _____ ft.

Sand _____

Gas _____

Oil _____

Total Depth *1531*

PRODUCTION

1st 24 hrs. Nat. _____

1st 24 hrs. after shot _____

Gas _____ Cu. Ft.

Dry Hole

Abandoned

Date

NOV 3 1926

192

CHAS. L. SHERWOOD

Scout