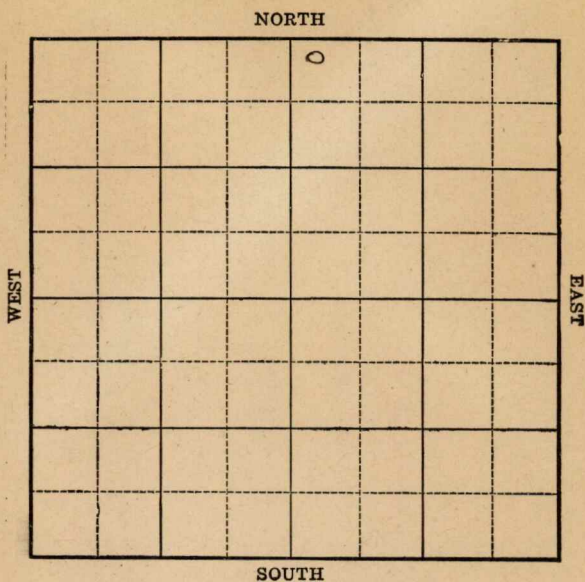


Map No. _____ Sec. 28 Twp. 29 R. 5Well No. 2 Hyman FarmEskenberry Company

Location _____

Drilling Remarks:

Rig up _____

Drilling Remarks:

RECORD

Cased _____ in. _____ ft.

Sand _____

Gas _____

Oil _____

Total Depth _____

PRODUCTION

1st 24 hrs Nat. _____

1st 24 hrs. after shot _____

Gas _____ cu. ft.

Dry Hole _____

Abandoned _____

Map No. _____ Sec. 28 Twp. 29 R. 5


Well No. 2 Hyman Farm
Eikenberry Company

200 Ft. from N. Line

Ft. from S. Line

Ft. from E. Line

200 Ft. from W. Line

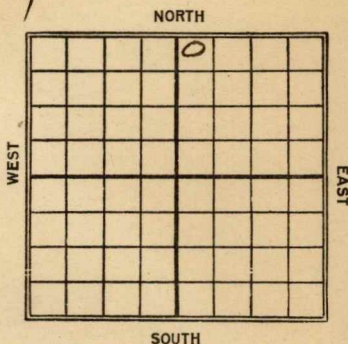

Date 1923

REPORT

3/30

6/10

1

Spur

$\phi + a. 2890'$

Map No. **KANSAS** 11 Sec. **28** Twp. **29** R. **6**

Well No. **2 Hyman**

Eikenberry Company

Contractor

FIRST REPORT

SECTION PLAT

200 Ft. from N. Line

_____ Ft. from S. Line

_____ Ft. from E. Line

200 Ft. from W. Line

		0	

Location _____

Rig up _____

Drilling and Remarks:

Spud.

RECORD

Cased _____ in., _____ ft.

Sand _____

Gas _____

Oil _____

Total Depth _____

PRODUCTION

1st 24 hrs. Nat. _____

1st 24 hrs. after shot _____

Gas _____ Cu. Ft.

Dry Hole _____

Abandoned _____

Date **MAR 30 1923**

M. A. BENEAR

192

Scout

Map No. **KANSAS** 11 Sec. **28** Twp. **29** R. **5**Well No. **2** *Hyman**Eikenberry* Company

Contractor

ABANDONED SECTION PLAT**200** Ft. from N. Line

Ft. from S. Line

Ft. from E. Line

200 Ft. from W. Line

		0	

Location

Rig up

Drilling and Remarks:

2049**2890'****RECORD**

Cased _____ in., _____ ft.

Sand _____

Gas _____

Oil _____

Total Depth _____

PRODUCTION

1st 24 hrs. Nat. _____

1st 24 hrs. after shot _____

Gas _____ Cu. Ft.

Dry Hole _____

Abandoned _____

Date

M. A. BENEAR**JUN 10 1923****192**

Scout