


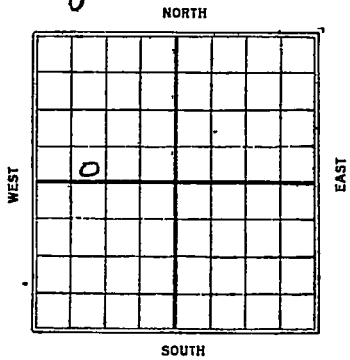

Map No. Kansas Sec. 14 Twp. 26 R. 14

Well No. 1 Underwood Farm  
R. L. Brunegar Company

\_\_\_\_\_ Ft. from N. Line  
200 Ft. from S. Line  
 \_\_\_\_\_ Ft. from E. Line  
1120 Ft. from W. Line



Date	REPORT
1925	
8/19	Spudding
9/24	1. Orly @ 400'
10/1	✓ ✓ 790
10/8	_____
10/16	SD. @ 1320
10/22	_____
10/29	_____
11/6	_____
11/13	_____
11-19	_____
11/27	_____
12/3	_____
12/10	_____
12/17	_____
12/23	_____
12/31	_____
<del>1926</del>	
1/8	_____
1/14	_____
1/20	D. & A. 1530

Woodson Co

Map No. **KANSAS** Sec. *14* Twp. *26* R. *14*

Well No. *1 Underwood*

*H. L. Brinegar* Company

Contractor

**FIRST REPORTS**

**SECTION PLAT**

\_\_\_\_\_ Ft. from N. Line

*200* Ft. from S. Line

\_\_\_\_\_ Ft. from E. Line

*1120* Ft. from W. Line


Location \_\_\_\_\_

Rig up *"Machine"*

Drilling and Remarks:

*Spudding*

**RECORD**

Cased \_\_\_\_\_ in., \_\_\_\_\_ ft.

Sand \_\_\_\_\_

Gas \_\_\_\_\_

Oil \_\_\_\_\_

Total Depth *14* \_\_\_\_\_

**PRODUCTION**

1st 24 hrs. Nat. \_\_\_\_\_

1st 24 hrs. after shot \_\_\_\_\_

Gas \_\_\_\_\_ Cu. Ft.

Dry Hole \_\_\_\_\_

Abandoned \_\_\_\_\_

Date

SEP 19 1925 <sub>192</sub>

**CHAS. L. SHERWOOD**

Scout

Woodhous Co

no map

Map No. **KANSAS** Sec. **14** Twp. **26** R. **14**

Well No. **1 Underwood**

**R. L. Binegar**

Company

Contractor

**COMPLETED**

**SECTION PLAT**

\_\_\_\_\_ Ft. from N. Line

**200** Ft. from S. Line

\_\_\_\_\_ Ft. from E. Line

**1120** Ft. from W. Line


**ABANDONED**

Location \_\_\_\_\_

Rig up \_\_\_\_\_

Drilling and Remarks:

**Dry & hard**

**20 1530'**

**No Sand**

**RECORD**

Cased \_\_\_\_\_ in., \_\_\_\_\_ ft.

Sand \_\_\_\_\_

Gas \_\_\_\_\_

Oil \_\_\_\_\_

Total Depth **1530'**

**PRODUCTION**

1st 24 hrs. Nat. \_\_\_\_\_

1st 24 hrs. after shot \_\_\_\_\_

Gas \_\_\_\_\_ Cu. Ft.

Dry Hole

Abandoned \_\_\_\_\_

Date

**JAN 20 1926**

**CHAS. L. SHERWOOD**

192

Scout