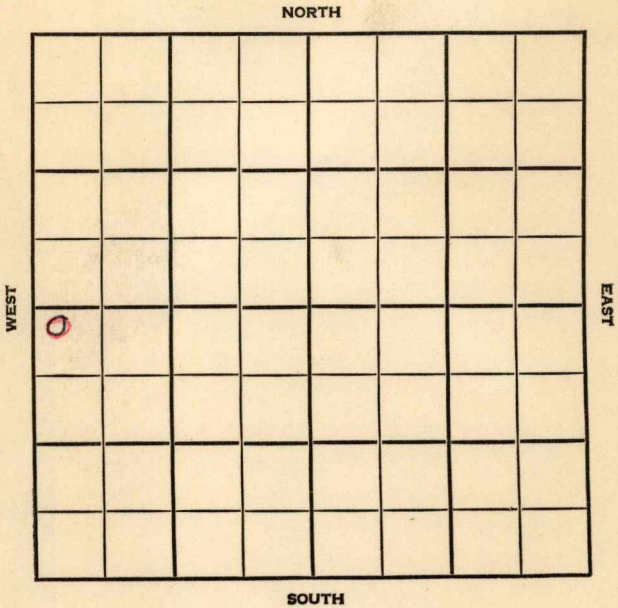


Butler

KANSASSection 30 Township 29 Range 5EWell No. #1DeFordCompany Butler Co. Drlg. Co.

Butler

KANSAS

SEC.	30	TWP.	29	R.	5E
------	----	------	----	----	----

WELL NO.

1 DeFord

FARM

COMPANY

Butler Co. Drlg Co.

CONTRACTOR

Co. Tools


Semi-Wildcat

_____ Ft. from N. Line

_____ Ft. from S. Line

_____ Ft. from E. Line

_____ Ft. from W. Line

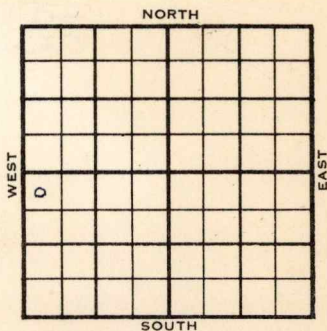

NW NW SW

1955	ELEVATION	REPORT
------	-----------	--------

5/26

RUST

6/29

Comm 5-27-55

KC 2240

M Ch 2853

M Im 2873

TD 2904

HFW @ 852 13 3/8" @ 853

10" @ 1680 8 1/4" @ 2019

D & A

ABANDONED

Co. _____ Facet _____

FORM 513 REV. SUNRAY

County Butler Elev. _____
 Sec. 30 Twp. 29 Rge. 5E
 Company Butler Co. Drlg. Co.
 Farm Name DeFord No. 1

TOPS	DEPTH	LOG	DATUM	Loc. in Sec.
Anh.				NW NW SW
T.p.				
H.				
Tr.				
Dg.				
B.L.				
L.				Geol.
K.C.				
B.K.C.				Contr.
Ce.				Co. tools
C.				
M.				Pool
M.				SemiWildcat
K.				
Mz.				
Me.				
V.				
S.				
S.				
A				
R.				
PE.				
G.				
TR.				

Date Comm.
RUST

County Butler Elev. _____
 Sec. 30 Twp. 29 Rge. 5E
 Company Butler Co. Drilg. Co.
 Farm Name DeFord No. 1

TOPS	DEPTH	LOG	DATUM	Loc. in Sec.
Anh.				NW NW SW
Tr.				
Dg.				
Bl.				
L.				
K.C.	2240		971	Geol.
B.K.C.				Contr.
Ce.				Co. tools
C.				Pool
M. ch	2853		1584	
M. Lm	2873		1604	
K.				Semi Wildcat
Mz.				
Mq.				
V.				
S.				
S.				
A.				
R.				
P.C.				
G.				
T.D.	2904		1635	

Date Comm. 5-27-55 JUN 29 1955

HFW @ 852 13/ 3/8" @ 853 10" @ 1680

8 1/4" @ 2019

D & A

