


Section 31 Township 29 Range 5 E

Well No. # 1 Gilmer

Company Rex & Morris

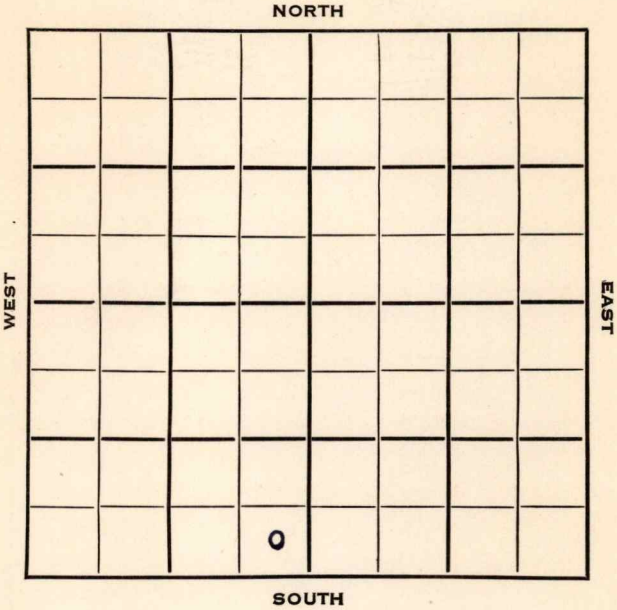

Butler

KANSAS ✓

Sec. 31 Twp. 29 R. 5EWell No. 1 Gilmer FarmRex & Morris

Company


Rex & Morris

Contractor

Wildcat Ft. from N. Line330 Ft. from S. Line330 Ft. from E. Line Ft. from W. Line

SE SE SW

H.H. Blair - DHM

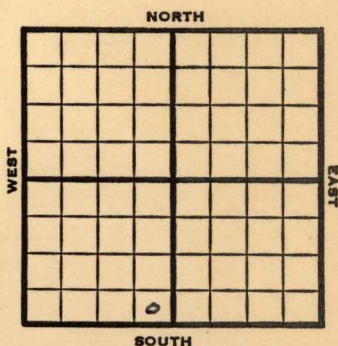

1953

Elev. 1259'

REPORT

4/15

Location

5/13

Spud 5-2-53 D & A TD 2847

KC 2200 B KC 2235 Miss ch. 2839

Miss. line 2846'

TD 2847' D & A

ABANDONED

County Butler State Kansas
 Sec. 31 (Blk. 29 (Sur. 5E (Twp. Rge. Map No.

Operator Rex & Morris

Well No. 1 Farm Gilmer

Elev. 1259 Location SE SE SW



330 Ft. From S Line SW

330 Ft. From E Line Quarter

1st. Report

Completion MAY 13 1953

Remarks Wildcat

Rex & Morris - Contr.

Spudding Date 5-2-53


Drlg. Data D & A TD 2847

KC 2200 B KC 2235 Miss. ch. 2839

Miss. lime 2846 TD 2847

D & A

J. G. McGEHEE

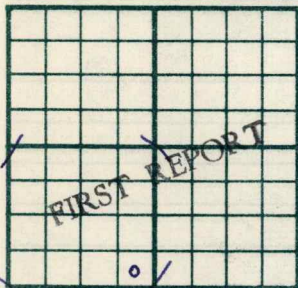County **Butler** State **Kansas**Sec. **31** (Blk.) **29** (Sur. Rge.) **5E** Map No.Operator **Rex & Morris**Well No. **1** Farm **Gilmer**Elev. Location **SE SE SW****330** Ft. From **S** Line **SW****330** Ft. From **E** Line Quarter1st. Report **APR 15 1953**

Completion

Remarks **H.H. Blair - DNM****Rex & Morris - Contr.**

Spudding Date

Drlg. Data

Wildcat**Location**