


Section 31 Township 29 Range 5 E

Well No. # 1 Miller

Company E. M. Clickner

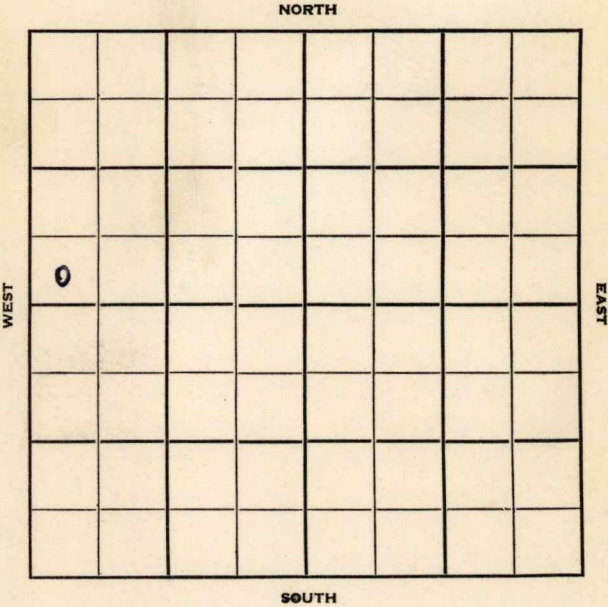


Butler

KANSAS

5E

Sec. 31 Twp. 29 R. 5EWell No. #1 Miller FarmE.M. Clickner CompanyMorrison Drlg. Contractor
Wildcat. Ft. from N. Line330 Ft. from S. Line Ft. from E. Line330 Ft. from W. Line

SW SW NW

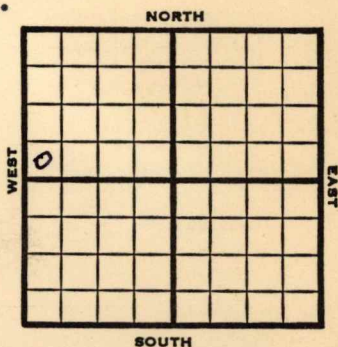1953 **Elev. -** REPORT

6/17 Spud 6-6-53
8" @ 105'
Drlg 2150'

6/24 Spud 6-6-53
D&A
TD 3475
8" @ 105'
KC 2176, Miss 2800, Simp 3189, Arb. 3239
DST 3283-96, opn 1 hr., rec. 60' mud,
240' sw, 1265#
TD 3475
D&A

ABANDONED

J. G. McGEHEE

County Butler State Kansas
 Sec. 31 (Blk. 29 (Sur. 5E Map No.
 (Twp.) (Rge.)
 Operator E. M. Clickner
 Well No. 1 Farm Miller
 Elev. Location SW SW NW



330 Ft. From S Line NW
330 Ft. From W Line Quarter
 1st. Report
 Completion JUN 24 1953
 Remarks Wildcat
Morrison Drlg. - Contr.
 Spudding Date 6-6-53

Drlg. Data D & A TD 3475
8" @ 105 KC 2176 Miss. 2800

Simp. 3189 Arb. 3239 DST 3283-96

open 1 hr. Rec. 60' mud 240' sw

1265# TD 3475

D & A

J. G. McGEHEE