

KANSAS

Butler

Section 33 Township 29 Range 5E

Well No. #1 Gibson

Company Kewanee Oil

Miscellaneous

NORTH

WEST

EAST

o

SOUTH

KANSAS

Butler

Sec. 33 Twp. 29 R. 5E

Well No. #1 Gibson Farm


Kewanee Oil Company
Misc.

 Ft. from N. Line

330 Ft. from S. Line

990 Ft. from E. Line

 Ft. from W. Line

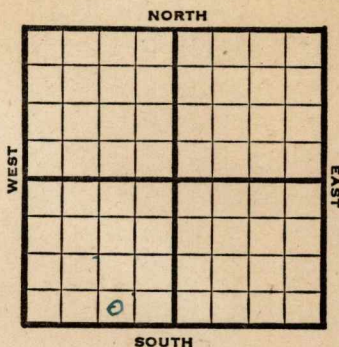

SW SE SW

1947

Elev. 111305' REPORT

10/15 Location

10/22 Mach.

10/29 15" @ 350'
Drlg. 625'

11/5 12" @ 1180'
Drlg. 1420'

11/12 10" @ 1460'
Drlg. 1850'

11/19 1850 UR 10"

11/25 "

12/3 10" @ 1850'
8" @ 2050'
Drlg. 2115'

12/10 Bart 2842
7" @ 2844
TD 2848'

Lansing 2215'
KC 2395'

12/23 Bart. 2843'
7" @ 2844'
Miss. 2856'
Pump 50 Pot
Gr. 38.0
TD 2858'

COMPLETED

Map No. _____ Sec. 33 Twp. 29 R. 5E

Well No. 1 Gibson

Kewanee Oil


Company

FIRST REPORT

Contractor

SW SE SW

SECTION PLAT

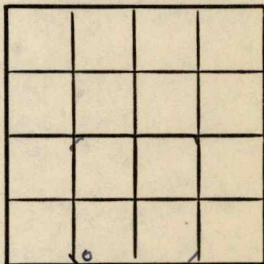

_____ Ft. from N. Line

630 Ft. from S. Line

990 Ft. from E. Line

_____ Ft. from W. Line

Butler County

Location X

Rig up _____

Drilling and Remarks:

RECORD

Cased _____ in., _____ ft.

Sand _____

Gas _____

Oil _____

Total Depth _____

PRODUCTION

1st 24 hrs. Nat. _____

1st 24 hrs. after shot _____

Gas _____ Cu. Ft.

Dry Hole _____

Abandoned _____

Date

OCT 15 1947 19

S. J. LEWIS

Scout

Map No. 11 Sec. 33 Twp. 29 R. 5E

Well No. 1 Gibson

Kewanee Oil Company

COMPLETE

Contractor

SW SE SW

E 11305
SECTION PLAT

 Ft. from N. Line

330 Ft. from S. Line

990 Ft. from E. Line

 Ft. from W. Line

Butler County

Location

Rig up

Drilling and Remarks:

Bar 2843

7" @ 2844

Miss 2856

Pump 50 Bk

2856

RECORD

Cased in., ft.

Sand

Gas

Oil

Total Depth 2858

PRODUCTION

1st 24 hrs. Nat.

1st 24 hrs. after shot

Gas Cu. Ft.

Dry Hole

Abandoned

Date

DEC 23 1947

19

S. J. LEWIS

Scout