

Gowley

KANSAS

Section 15 Township 34 Range 3EWell No. #4 FunkCompany Smitherman & Cohen

NORTH

/

							0

SOUTH

WEST

EAST

KANSAS ✓

Sec. 15 Twp. 34 R. 3EWell No. #1 Funk FarmSmitherman & Cohen Company

Contractor


990 Ft. from N. Line

Ft. from S. Line

330 Ft. from E. Line

Ft. from W. Line

SE NE NE

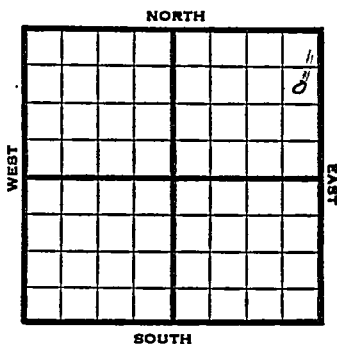

1953 Elev. 1180 REPORT

2/18 Location

4/1 Spud 2-15-53 Oil well TD 3376
 8" @ 105 Layton 2608' Bart. 3369
 TD 3374 5" @ 3369 DD 3376
 PB 3372 Hydro.
 Comp. 82 BOPD 7% wtr.

COMPLETED

County Cowley State KansasSec. 15 (Blk. Twp.) 34 (Sur. Rge.) 3E Map No. _____Operator Smitherman & CohenWell No. 4 Farm FunkElev. 1180 Location SE NE NE

							0

990 Ft. From N Line NE330 Ft. From E Line Quarter1st. Report FEB 18 1953

Completion _____

Remarks _____

Spudding Date _____

Drlg. Data _____

Location _____

County Cowley State Kansas
 Sec. 15 (Blk. 34 (Sur. 3E Map No.)
 (Twp.) (Rge.)
 Operator Smitherman & Cohen
 Well No. 4 Farm Funk
 Elev. 1180 Location SE NE NE

							0

990 Ft. From N Line NE

330 Ft. From E Line Quarter

1st. Report

Completion APR 1 1953

Remarks

Spudding Date 2-15-53

Drig. Data Oil well TD 3376

8" @ 105 Layton 2608 Bart. 3369

TD 3374 5" @ 3369 DD 3376 PB 3372

Hydro. Comp. 82 bopd 7% wtr.

J. G. McGEHEE