

KANSAS Russell

Section 22 Township 15 Range 14W

Well No. 4 Dietz

Company Derby Oil et al

Trapp Pool

NORTH

WEST

EAST

					0		

SOUTH

KANSAS

Russell

Sec. 22 Twp. 15 R. 14W ✓

Well No. #4 Dietz Farm

Derby Oil et al Company


Trapp Pool

 Ft. from N. Line

990' Ft. from S. Line

 Ft. from E. Line

990' Ft. from W. Line

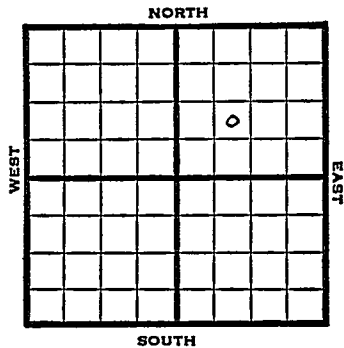

NE SW NE

1949 ¹⁸³⁹
Elev 1837' **REPORT**

1/12	Location
1/19	"
1/26	"
2/2	"
2/9	Location
2/16	"
2/23	"
3/2	"
3/8	"
3/16	8" @ 662'
3/23	5" @ 3281'
	Drlg. 3285'
3/30	Lansing 3036'
	Arb. 3283'
	4" @ 3284'
	TD 3289'
	500 acid
4/6	Swb 1 1/4 bbls oil PH
	TD 3293'
	40 qts 3284-92
	1000 acid
	Swb 20 W PH
	PB 3285'
4/12	Swb 2 3/4 bbls oil PH 16 hrs.
4/20	"
4/27	"
5/4	TD 3293'
	Lans 3036'
	Arb. 3283'
	4" @ 3284'
	1000 acid
	Pump 62 oil Pot

40⁹ Gr.
Gomp

COMPLETED

Map No. _____ Sec. 22 Twp. 15 R. 14W

Well No. 4 Dietz

Derby Oil etal. Company

FIRST REPORT Contractor

NE S¹ NE


SECTION PLAT

_____ Ft. from N. Line

990 Ft. from S. Line

_____ Ft. from E. Line

990 Ft. from W. Line

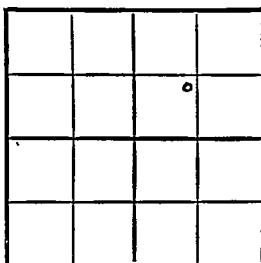

Russell County

Location X

Rig up _____

Drilling and Remarks: _____

RECORD

Cased _____ in., _____ ft.

Sand _____

Gas _____

Oil _____

Total Depth _____

PRODUCTION

1st 24 hrs. Nat. _____

1st 24 hrs. after shot _____

Gas _____ Cu. Ft.

Dry Hole _____

Abandoned _____

Date

JAN 1 2 1949 19 S. J. LEWIS Scout

Kansas

Map No. K-73 Sec. 22 Twp. 15 R. 14WWell No. 4 DietzDerby Oil et al.

Company

COMPLETE

Contractor

NE SW NE

E. 1839
SECTION PLAT

		6	

 Ft. from N. Line990 Ft. from S. Line Ft. from E. Line990 Ft. from W. Line**Russell County**Location Rig up

Drilling and Remarks:

Lease 3086CR 32534" 32541000 and 6Prod 62 oil Pt4 1/2 in**RECORD**Cased in., ft.Sand Gas Oil Total Depth 3293**PRODUCTION**1st 24 hrs. Nat. 1st 24 hrs. after shot Gas Cu. Ft.Dry Hole Abandoned

Date

MAY 4 1949 19S. J. LEWIS

Scout