


Section 33 Township 29 Range 5EWell No. 4 GibsonCompany Kewanee Oil

KANSAS

Butler

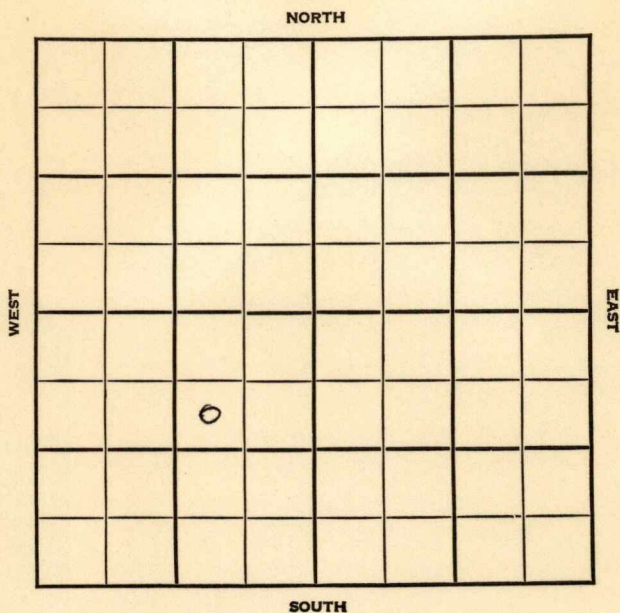

Sec. 33 Twp. 29 R. 5E

Well No. #4 Gibson Farm
Kewanee Oil Company

Misc.


990 Ft. from N. Line

 Ft. from S. Line

990 Ft. from E. Line

 Ft. from W. Line

SW NE SW

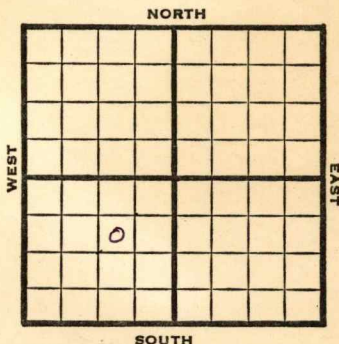

1948

Elev. 1243' REPORT

4/28

Location

5/5

Drlg. 260'

5/12

13" @ 287'

12" @ 825'

Drlg. 1230'

5/19

10" @ 1475'

Drlg. 1655'

5/26

8" @ 1755'

KC 2135'

2525' Drlg.

6/1

Bart. 2762'

TD 2780'

5" @ 2765'

6/9

Bart. 2762'

5" @ 2765'

55 qts.

Pump 40 oil pot

40.0 Gr.

TD 2798'

Compl

COMPLETED

Map No. _____ Sec. 33 Twp. 29 R. 5E

Well No. 4 Gibson

Kewanee Oil Company

FIRST REPORT

Contractor

SW NE SW

SECTION PLAT

990 Ft. from N. Line

_____ Ft. from S. Line

990 Ft. from E. Line

_____ Ft. from W. Line

Butler County

Location X

Rig up _____

Drilling and Remarks:

RECORD

Cased _____ in., _____ ft.

Sand _____

Gas _____

Oil _____

Total Depth _____

PRODUCTION

1st 24 hrs. Nat. _____

1st 24 hrs. after shot _____

Gas _____ Cu. Ft.

Dry Hole _____

Abandoned _____

Date

APR 28 1948

19

S. J. LEWIS

Scout

Map No. 11 Sec. 33 Twp. 29 R. 5E

Well No. 4 Gibson

Kewanee Oil Company

COMPLETE

Contractor

SW NE SW

E 11248
SECTION PLAT

990 Ft. from N. Line

 Ft. from S. Line

990 Ft. from E. Line

 Ft. from W. Line

Butler County

Location

Rig up

Drilling and Remarks:

Bar 2762

5" @ 2765

559 to

Pump 40 oil

BT

40 = 1/2 gal

RECORD

Cased in., ft.

Sand

Gas

Oil

Total Depth 2798

PRODUCTION

1st 24 hrs. Nat.

1st 24 hrs. after shot

Gas Cu. Ft.

Dry Hole

Abandoned

Date

JUN 9 1948

19

S. J. LEWIS

Scout