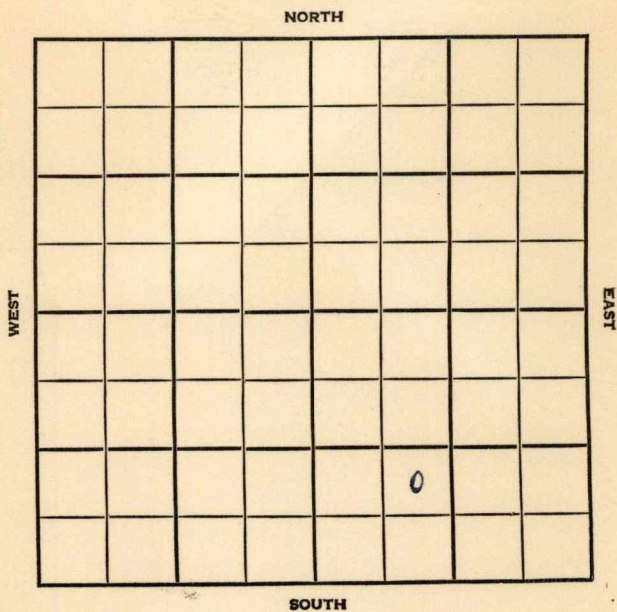


Section 29 Township 29 Range 5 EWell No. # 1 ZinkCompany Rex & Morris

SEC.	TWP.	R.
29	29	5E

WELL NO.

#1 Zink FARM

COMPANY

Rex & Morris

CONTRACTOR

Co. Tools

Fox-Bush Pool


NORTH

Ft. from N. Line

990 Ft. from S. Line

Ft. from E. Line

990 Ft. from W. Line

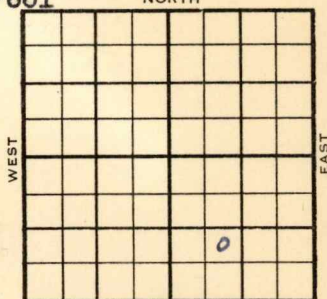

SOUTH

NE SW SE

1954	ELEVATION	REPORT
------	-----------	--------

11/17

Spud -

D & A

TD 2877'

KC 2224' B KC 2458' Cherokee 2670'

Miss Ch 2848', Miss Lime 2859'

TD 2877'

D & A

FIRST REPORT

ABANDONED

County **Butler** State **Kansas**
Sec. **29** (Blk.) **29** (Sur.) **5E** Map No.
Operator **Rex & Morris**
Well No. **1** Farm **Zink**
Elev. Location **NE SW SE**



990 Ft. From **S** Line **SE**
990 Ft. From **W** Line Quarter
1st. Report **NOV 17 1954**
Completion **NOV 17 1954**
Remarks **Fox-Bush Pool**
Co. tools

Spudding Date

Drlg. Data **D & A** **TD 2877**

KC 2224 B KC 2458 Cherokee 2670

Miss. ch. 2848 Miss. lime 2859 TD 2877

D & A

FABEN GILSTRAP