

KANSAS


Form 51—5M—7-39—Palace

Butler

Section 32 Township 29 Range 5-E

Well No. #1 Zink

Company Allison & Talbott

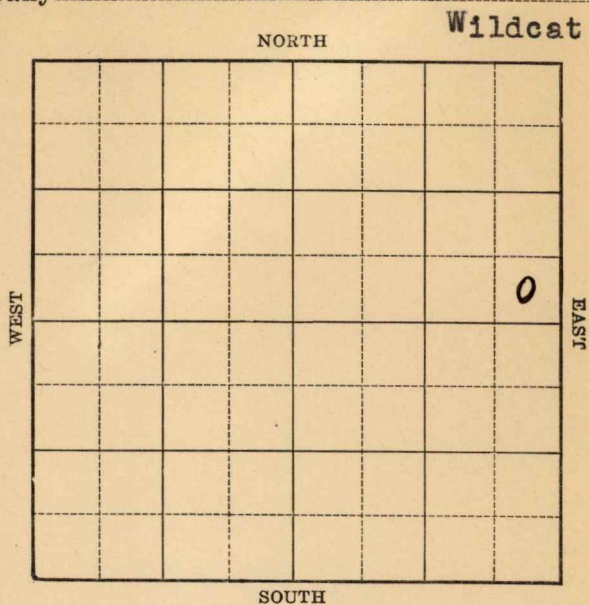

KANSAS


Butler

Sec. 32 Twp. 29 R. 5-EWell No. #1 Zink FarmAllison & Talbott Company

(Wildcat)

 Ft. from N. Line330 Ft. from S. Line330 Ft. from E. Line Ft. from W. Line

Elev. 1236

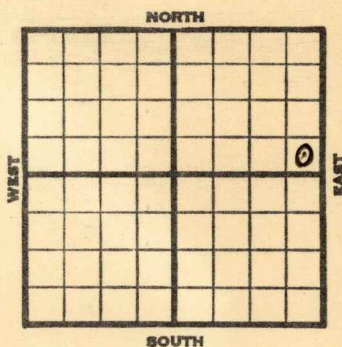

1939	REPORT
9/27	Location
10/5	Machine.
10/12	20" - 20' 15" - 191'
	Spud 255'
10/19	12" - 755' Drlg.
10/26	SD 805'
11/2	Drlg. 1440'
11/9	10" - 1895' Drlg. 1915'
11/16	K. C. 2125' S.O. 2140-2505'
	Drlg. 2505'
11/23	T.D. 2710' Fsg. tools.
11/29	" " " "
12/7	" " " "
12/14	" " " "
12/21	Could not get tools.
	Skid rig 70' NE.
12/28	" " " "
1940	
1/4	18" - 190' Drlg. 205'
1/11	15" - 267' Drlg. 815'
	OVER

1940
1/18 12" - 768'
Drlg. 1520'
1/25 SD 1550'
2/1 Drlg. 1600'
2/8 8" - 1987' Drlg. 2350'
2/15 Miss. 2770' 7" - 2780'
Drlg. 2785'
2/21 Arb. 3216' water.
T.D. 3224'

ABANDONED

Map No. 11 Sec. 32 Twp. 29 R. 5EWell No. 1 ZinkAllison & Talbott

Company

Contractor

FIRST REPORT

SE NE

SECTION PLAT

			o

 Ft. from N. Line330 Ft. from S. Line330 Ft. from E. Line Ft. from W. Line

WILDCAT

Location XRig up

Drilling and Remarks:

RECORD

Cased in., ft.Sand Gas Oil Total Depth

PRODUCTION

1st 24 hrs. Nat. 1st 24 hrs. after shot Gas Cu. Ft.Dry Hole Abandoned

Date

SEP 27 1939

19

S. J. LEWIS

Scout

Map No. 11 Sec. 32 Twp. 29 R. 5EWell No. 1 ZinkAllison & Talbott

Company

Contractor

ABANDONED

SE NE

SECTION PLAT

 Ft. from N. Line330 Ft. from S. Line330 Ft. from E. Line Ft. from W. Line

WILDCAT

Location Rig up

Drilling and Remarks:

*See 3216**Water*

RECORD

Cased in., ft.Sand Gas Oil Total Depth 3224

PRODUCTION

1st 24 hrs. Nat. 1st 24 hrs. after shot Gas Cu. Ft.Dry Hole Abandoned

Date

FEB 21 1940 19

S. J. LEWIS Scout