

KANSAS

Butler

Section 33 Township 29 Range 5E

Well No. #3 Gibson

Company Kewanee Oil

Miscellaneous

NORTH

WEST

EAST

SOUTH

KANSAS

Butler



Sec. 33 Twp. 29 R. 5E

Well No. #3 Gibson Farm

Kewanee Oil Company

Miscellaneous


Ft. from N. Line

990' Ft. from S. Line

990' Ft. from E. Line

Ft. from W. Line

NW SE SW

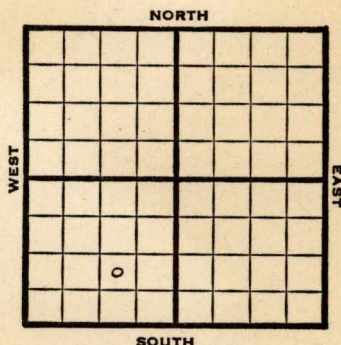

1948 **Elev. 1306'** **REPORT**

2/25 15" @ 356'
12" @ 785'
Drlg. 850'

3/3 10" @ 1785'
Drlg. 1800'

3/10 8" @ 2060'
Drlg. 2625'

3/17 7" @ 2822'
Bart. 2834'
TD 2858'
60 qts. 2834-58'
CO

3/24 "

3/31 **Bart 2834'**
7" @ 2822'
60 qts 2834-58
Pump 45 Pot.
Gr. 38°
TD 2858'

COMPLETED

Map No. _____ Sec. 33 Twp. 29 R. 5E

Well No. 3 Gibson

Kewanee Oil Company

FIRST REPORT Contractor

NW SE SW

SECTION PLAT

	0		

_____ Ft. from N. Line

990 Ft. from S. Line

990 Ft. from E. Line

_____ Ft. from W. Line

Butler County

Location _____

Rig up _____

Drilling and Remarks:

15" @ 356

12" @ 785

drlg. 850

RECORD

Cased _____ in., _____ ft.

Sand _____

Gas _____

Oil _____

Total Depth _____

PRODUCTION

1st 24 hrs. Nat. _____

1st 24 hrs. after shot _____

Gas _____ Cu. Ft.

Dry Hole _____

Abandoned _____

Date

FEB 25 1948 19 S. J. LEWIS Scout

Map No. 11 Sec. 33 Twp. 29 R. 5E

Well No. 3 Gibson

Kewanee Oil Company

COMPLETE

Contractor

NW SE SW

E 1, 1306.
SECTION PLAT

 Ft. from N. Line

990 Ft. from S. Line

990 Ft. from E. Line

 Ft. from W. Line

	6		

Butler County

Location

Rig up

Drilling and Remarks:

Bar 72834
7' 62822
609 to 2534-58.
Jump 45 ft.
380 ft

RECORD

Cased in., ft.

Sand

Gas

Oil ✓

Total Depth 2808

PRODUCTION

1st 24 hrs. Nat.

1st 24 hrs. after shot

Gas Cu. Ft.

Dry Hole

Abandoned

Date

MAR 31 1948

19

S. J. LEWIS

Scout