

KANSAS

Butler

Section 34 Township 29 Range 5EWell No. 1 DillerCompany E. Adair et al

Misc.

NORTH

				0			

WEST

EAST

SOUTH

KANSAS Butler ✓

Sec. 34 Twp. 29 R. 5E

Well No. 1 Diller Farm

E. Adair et al Company

Misc.


150 Ft. from N. Line

_____ Ft. from S. Line

_____ Ft. from E. Line

330 Ft. from W. Line

NW NE

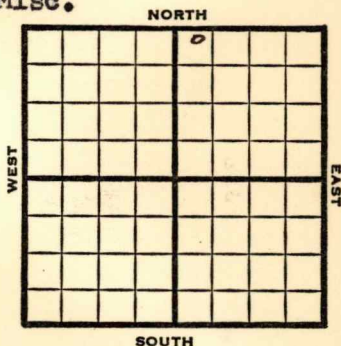

1948 Elev. 1295' REPORT

11/17	Machine
11/23	15" @ 330'
	Drlg 440'
11/30	Drlg. 1190'
	13" @ 770'
12/6	8" @ 1865'
	Drlg. 1935'
12/14	8" @ 1944'
	Lansing 2005'
	Drlg. 2105'
12/22	"
12/29	"
1949	
1/5	Miss 2832'
	TD 2841'
	ABANDONED

Map No. _____ Sec. 34 Twp. 29 R. 5E

Well No. 1 Diller

E. Adair etal. Company

FIRST REPORT Contractor

NW NE


SECTION PLAT

150 Ft. from N. Line

_____ Ft. from S. Line

_____ Ft. from E. Line

330 Ft. from W. Line

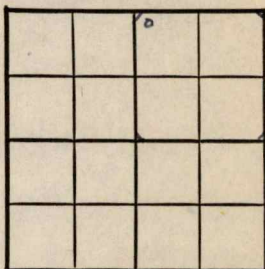

Butler County

Location _____

Rig up _____

Drilling and Remarks:

Machine

RECORD

Cased _____ in., _____ ft.

Sand _____

Gas _____

Oil _____

Total Depth _____

PRODUCTION

1st 24 hrs. Nat. _____

1st 24 hrs. after shot _____

Gas _____ Cu. Ft.

Dry Hole _____

Abandoned _____

Date


NOV 17 1948 19

S. J. LEWIS Scout

Kansas

Map No. 11 Sec. 34 Twp. 29 R. 5EWell No. 1 DillerE. Adair et al. Company**ABANDONED** Contractor

NW NE

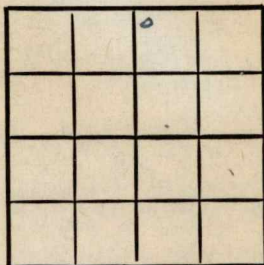E 1/2 1295
SECTION PLAT150 Ft. from N. Line Ft. from S. Line Ft. from E. Line330 Ft. from W. Line

Butler County

Location Rig up Drilling and Remarks: *Miss 2832***RECORD**Cased in., ft.Sand Gas Oil Total Depth 2841**PRODUCTION**1st 24 hrs. Nat. 1st 24 hrs. after shot Gas Cu. Ft.Dry Hole Abandoned

Date

JAN 5 1949

19

S. J. LEWIS

Scout