

Butler **KANSAS**

33


29

5E

Section _____ Township _____ Range _____

Well No. #1 Lanier

Company Kewanee Oil

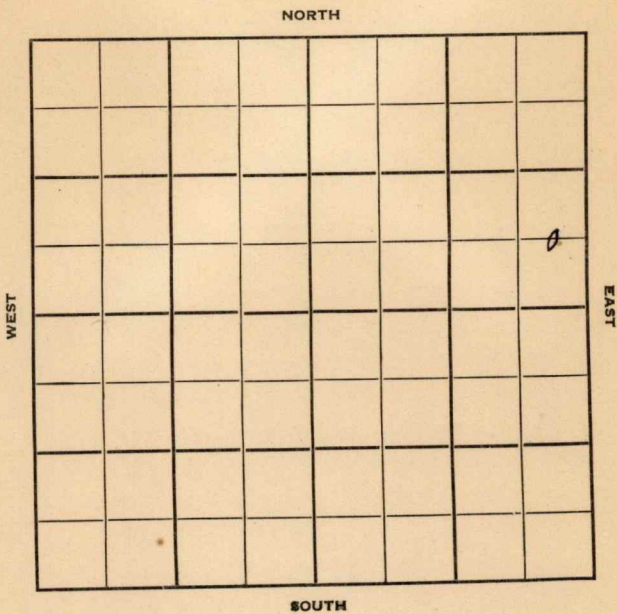

Sec. 33 Twp. 29 R. 5E

Well No. #1 Lanier Farm

Kewanee Oil Company

Contractor

Miscellaneous


_____ Ft. from N. Line

660' Ft. from S. Line

330' Ft. from E. Line

_____ Ft. from W. Line

C E L S E N E

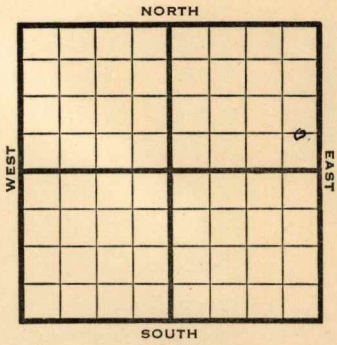

1950

Elev 1269

REPORT

4/26

Drlg. 150'

6/7

TD 2878

15" @ 298

13" @ 870

10" @ 2165

8" @ 1821

K.C. 2165

Miss 2923

D&A

ABANDONED

Map No. _____ Sec. 33 Twp. 29 R. 5E

Well No. 1 Lanier

Kewanee Oil Company

Contractor

C E L S E N E

SECTION PLAT



_____ Ft. from N. Line

660 Ft. from S. Line

330 Ft. from E. Line

_____ Ft. from W. Line

Butler County

Location _____

Rig up _____

Drilling and Remarks:

drlg. 150

RECORD

Cased _____ in., _____ ft.

Sand _____

Gas _____

Oil _____

Total Depth _____

PRODUCTION

1st 24 hrs. Nat. _____

1st 24 hrs. after shot _____

Gas _____ Cu. Ft.

Dry Hole _____

Abandoned _____

Date

APR 26 1950 19

J. E. TYRA

Scout

Form 26 200 Bks. 11-49 Petrol

Map No. _____ Sec. 33 Twp. 29 R. 5E
Kansas

Well No. 1 Lanier

Kewanee Oil Company

Contractor
C E L S E N E E1.1269

SECTION PLAT

_____ Ft. from N. Line
660 Ft. from S. Line
330 Ft. from E. Line
_____ Ft. from W. Line



Butler

Location _____

Rig up _____

Drilling and Remarks:

15' @ 298
13' @ 870
10' @ 2165
8' @ 1821
N.C. 2165
min 2823
T.D. 2878

RECORD

Cased _____ in., _____ ft.
Sand _____
Gas _____
Oil _____
Total Depth 2878

PRODUCTION

1st 24 hrs. Nat. _____
1st 24 hrs. after shot _____
Gas _____ Cu. Ft.
Dry Hole _____
Abandoned _____

Date

D + A

JUN 7 1950 19

J. E. TYRA Scout