


Section 15 Township 34 Range 3E

Well No. 2 - Oglesbee

Company Smitherman & Cohen

NORTH

8

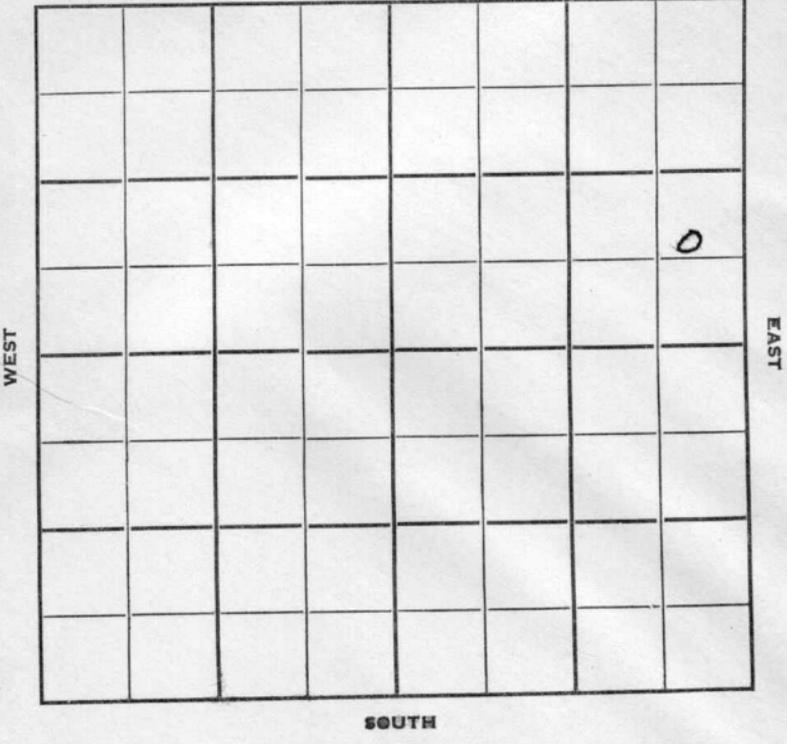

SOUTH

Cowley

KANSAS ✓

Sec. 15 Twp. 34 R. 3E

Well No. 2 Oglesbee Farm

Smitherman & Cohen Company

Contractor


Ft. from N. Line

990 Ft. from S. Line

330 Ft. from E. Line

Ft. from W. Line

NE SE NE

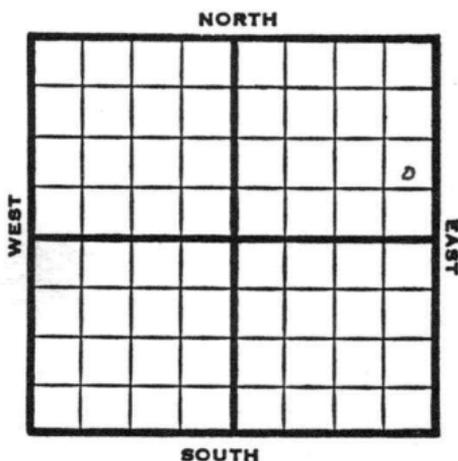

1952 Elev. 1181' REPORT

12/30 Location

1953
2/4

Oil Well
 TD 3371
 Layton 2660, KC 2835, Oswego 3057
 Bart 3333
 TD 3369
 5" @ 3359
 DD 3371 Hydro
 F/320 bo 8 hr.
 Comp. 539 bopd

COMPLETED

