

Butler

KANSAS

33

29

5E

SECTION

TOWNSHIP

RANGE

WELL NO.

#3 Zink

COMPANY

Kewanee Oil

NORTH

WEST

EAST

0							

SOUTH

Butler

KANSAS

SEC.	TWP.	R.
33	29	5E

WELL NO.

#3 Zink

FARM

COMPANY

Kewanee Oil

CONTRACTOR

Rex & Morris

Combs


_____ Ft. from N. Line

_____ Ft. from S. Line

_____ Ft. from E. Line

_____ Ft. from W. Line

SW SW SW

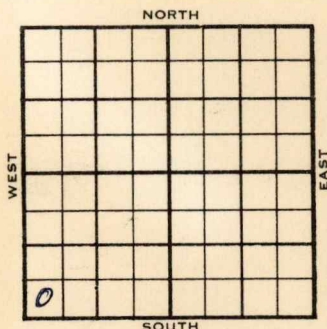

1956

ELEVATION

1271'

REPORT

4-11

Comm. 4-9-56

8" @ 168

WOC

6-6

5 1/2" @ 2837

40/ 2809-19

S/ 10 BO / 35 BW in 4 hrs.

P/ 13.4 BO, 80.4 BW pd.

Bartl. 2772'

Log tops: Bartl. 2771', Bartl. sd. 2798

KC. 2174', BKC. 2410', M. Chert 2821'.

TD 2840'

COMPLETED

Co.

County Butler Elev. 1271
 Sec. 33 Twp. 29 Rge. 5E
 Company Kewanee Oil
 Farm Name Zink No. 3

TOPS	DEPTH	LOG	DATUM	Loc. in Sec.
Anb.				SW SW SW
Tr.				
H. <u>Bartl.</u>	<u>2772</u>	<u>2771</u>		
Tr. <u>" sd</u>		<u>2798</u>		
Dg.				
B.L.				
L.				
K.C.		<u>2174</u>		Geol.
B.K.C.		<u>2410</u>		Contr.
Ce.				<u>Rex & Morris</u>
C. <u>chert</u>		<u>2821</u>		
M.				Pool
K.				Combs
Mz.				
Me.				
V.				
S.				
S.				
A.				
R.				
Pe.				
G.				
T.D.	<u>2840</u>			

Loc.

No.

Sec.

T.

R.

Date Comm.

4-9-56

JUN 6 1956

8" @ 168

WOC

APR 18 '56

10 2824APR 25 '56 5 1/2 @ 2837 40 / 2809-2019 MAY 2 '56 Frac & 10 B0 + 35BW in 4 hrs MAY 9 '56 MAY 16 '56MAY 23 '56 MAY 23 '56 JUN 6 '56 P 13.4 0080.4 BW PD

County Butler Elev. _____
 Sec. 33 Twp. 29 Rge. 5E
 Company Kewanee Oil
 Farm Name Zink No. 3

TOPS	DEPTH	LOG	DATUM	Loc. in Sec.
Anh.				SW SW SW
Tp.				
H.				
Tr.				
Dg.				
Bl.				
L.				Geol. _____
K.C.				Contr. _____
B.K.C.				<u>Rex & Morris</u>
Ce.				Pool _____
C.				<u>Combs</u>
M.				
M.				
K.				
Mz.				
Me.				
V.				
S.				
S.				
A.				
R.				
PE.				
G.				
T.D.				

FIRST REPORT
 APR 11 1956
 0

Date Comm. 4-9-56
8" @ 168 WOC

APR 17 1956

R. G.

29