

FORM 51


Cowley

KANSAS

Section 15 Township 34 Range 3E

Well No. #5 Oglesbee

Company Smitherman & Cohen

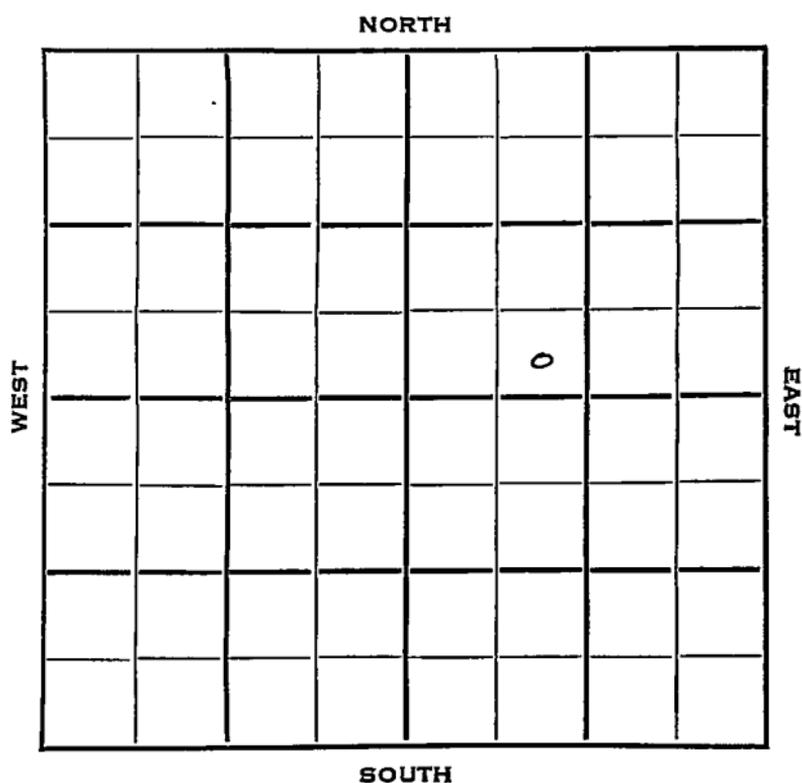

Cowley
34

15

3E

Sec. _____ Twp. _____ R. _____

#5 Oglesbee

Well No. _____ Farm _____

Smitherman & Cohen

Company

Contractor

_____ Ft. from N. Line

330


_____ Ft. from S. Line

_____ Ft. from E. Line

990

_____ Ft. from W. Line

SE SW NE

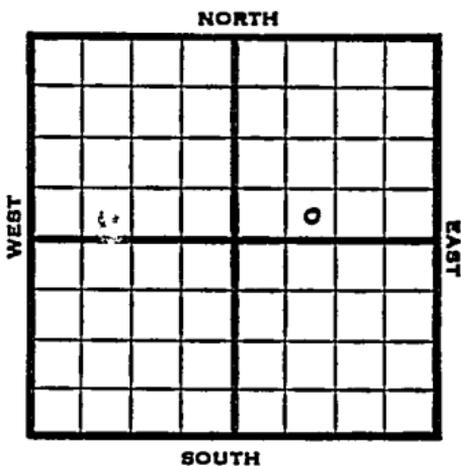

1953 Elev. 1104' REPORT

1/28 Location

3/4 Spud 2-6-53

Oil Well

TD 3294

8" @ 87

Bart 3270

TD 3275

5" @ 3270

DD 3294 Hydro

Comp. 3000 bopd

COMPLETED

