FORM 51 10M 7-48 PETROL

KANSAS


Rice

Section 19 Township 18 Range 7W

Well No. 7 Gray

Company Continental

Geneseo Pool

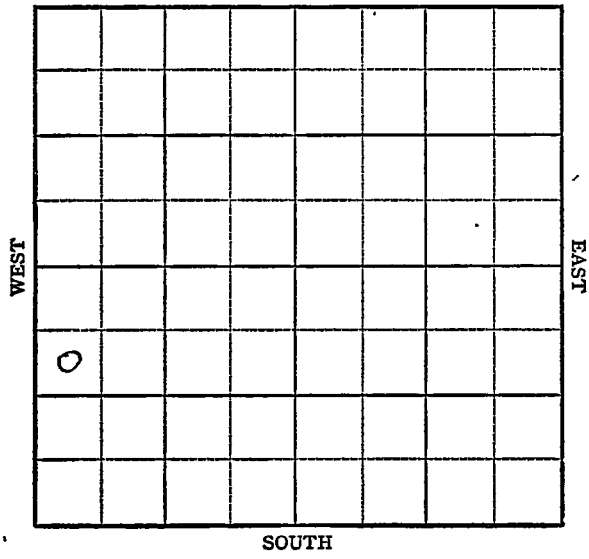

FORM 252-A
5M 4-48 PETROL

KANSAS Rice ✓

Sec. 19 Twp. 18 R. 7W

Well No. 7 Gray Farm

Continental Company

Geneseo Pool


990 Ft. from N. Line

Ft. from S. Line

Ft. from E. Line

330 Ft. from W. Line

SW NW SW

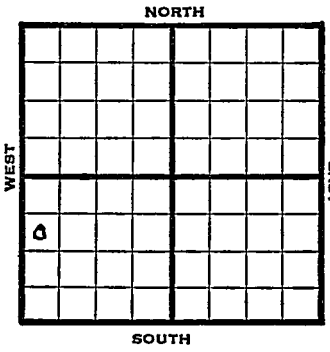

1948	Elv. 1691' REPORT
9/22	Rig
9/29	"
10/6	RUR
10/13	10"@ 395' Drlg 2063'
1948 10/19	Arb. 3104 TD 3114' 6"@ 3110'
10/26	TD 3149' Swb 23 oil 3 hrs.
11/3	Arb 3104 6" @ 3110' 2000 acid Echo Pot. 2182 oil & 22% W Gr. 41° TD 3149' COMPLETED

Form 27—100 Bks.—4-48—Petrol

Rice County Kansas State

Map No. Sec. 19 Twp. 18 R. 7W

Well No. 7 Gray

Continental Company

FIRST REPORT Contractor

SW NW SW


990 Ft. from N. Line

Ft. from S. Line

Ft. from E. Line

330 Ft. from W. Line

SECTION PLAT

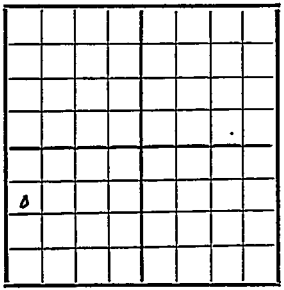

Geneseo pool

Remarks:

Rig

Date SEP 2 2 1948

Scout S. J. LEWIS

Form 26 200 Bks. 9-48 Petrol

Kansas

Geneseo Pool

Map No. 45 Sec. 19 Twp. 18 R. 7W

Well No. 7 Gray

Continental Company


COMPLETE

Contractor

SW NW SW

E.1691

SECTION PLAT

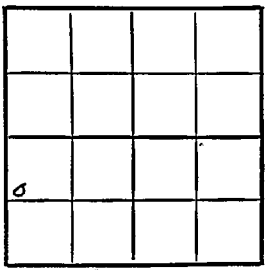

990 Ft. from N. Line

Ft. from S. Line

Ft. from E. Line

330 Ft. from W. Line

Rice County

Location

Rig up

Drilling and Remarks:

Cer #3104

6" @ 3110

2000 Gas C

Echo Pool #2182 oil

+ 22% W

412 Rel

RECORD

Cased in., ft.

Sand

Gas

Oil ✓

Total Depth 3149

PRODUCTION

1st 24 hrs. Nat.

1st 24 hrs. after shot

Gas Cu. Ft.

Dry Hole

Abandoned

Date

NOV 3 1948 19

S. J. LEWIS Scout