


KANSAS

Section 13 Township 15 Range 14W
 Well No. 3 Krug "F"
 Company Cities Service

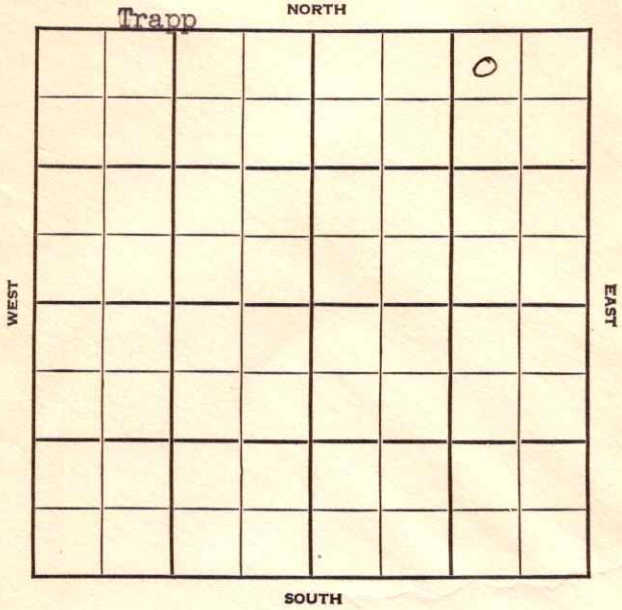

KANSAS

Russell

Sec. 13 Twp. 15 R. 14-W

Well No. #3 Krug "F" Farm

Cities Service Company

Trapp Pool


330' Ft. from N. Line

Ft. from S. Line

990' Ft. from E. Line

Ft. from W. Line

NW NE NE

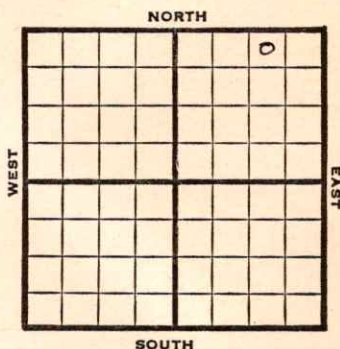

1947

Elev. 1881' REPORT

11/12 Location

11/19 RUR

11/25 8" @ 540'
Drlg. 2610'

12/3 **Arbuckle 3329'**
TD 3330'
5" @ 3329'
RUST

12/10 SLM 3330'-26'
Lansing 3067'
Arbuckle 3325'
5" @ 3325'
TD 3331'
Pump 25 bbls. oil 24 hrs.

12/17 **Arbuckle 3325**
5" @ 3325
Pump 218 oil / 4 W Pot
TD 3331'
Gravity 40.9

COMPLETED

Map No. _____ Sec. 13 Twp. 15 R. 14W

Well No. 3 Krug "F"

Cities Service Company

FIRST REPORT Contractor

NW NE NE

SECTION PLAT

330 Ft. from N. Line

_____ Ft. from S. Line

990 Ft. from E. Line

_____ Ft. from W. Line

			o

Russell County

Location X

Rig up _____

Drilling and Remarks:

RECORD

Cased _____ in., _____ ft.

Sand _____

Gas _____

Oil _____

Total Depth _____

PRODUCTION

1st 24 hrs. Nat. _____

1st 24 hrs. after shot _____

Gas _____ Cu. Ft.

Dry Hole _____

Abandoned _____

Date

NOV 12 1947 19 S. J. LEWIS Scout

Map No. 73 Sec. 13 Twp. 15 R. 14W

Well No. 3 Krug "F"

Cities Service

Company

COMPLETE

Contractor

NW NE NE

E. 1881
SECTION PLAT

			0

330 Ft. from N. Line

Ft. from S. Line

990 Ft. from E. Line

Ft. from W. Line

Russell County

Location

Rig up

Drilling and Remarks:

Per 8 3325

5" @ 3325

Pump 218 oil 7

4W Pad.

4035

RECORD

Cased in., ft.

Sand

Gas

Oil

Total Depth 1335'

PRODUCTION

1st 24 hrs. Nat.

1st 24 hrs. after shot

Gas Cu. Ft.

Dry Hole

Abandoned

Date

DEC 1 7 1947

19

S. J. LEWIS

Scout