

KANSAS


Form 51-5M-7-40-Palace

Rice

Section 19 Township 18 Range 7-W

Well No. 3 Hamilton "A"

Company Continental

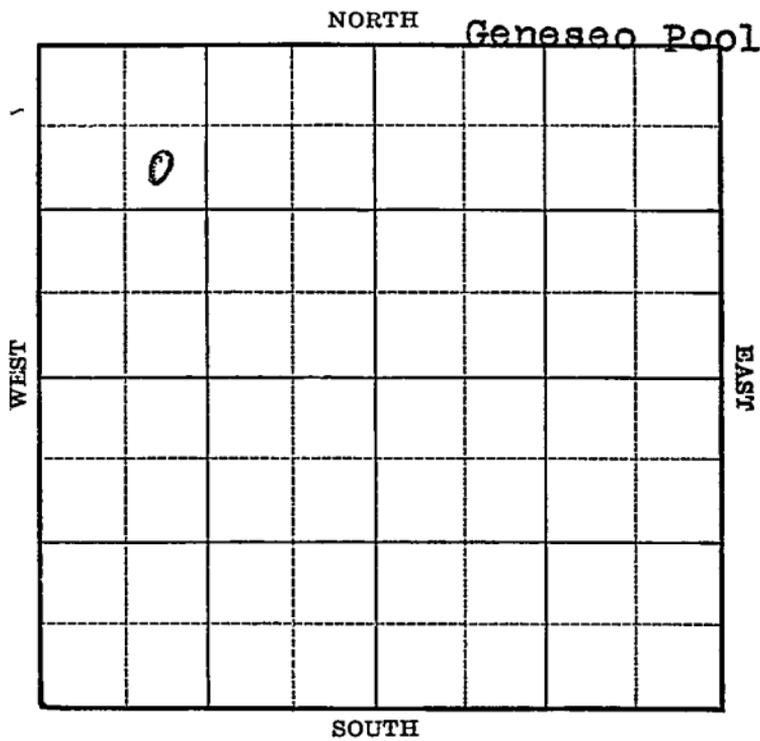

Sec. 19 Twp. 18 R. 7-W

Well No. #3 Hamilton "A" Farm

Continental

Company

(Gemeseo)


990 Ft. from N. Line

_____ Ft. from S. Line

_____ Ft. from E. Line

990 Ft. from W. Line

Elev. 1730

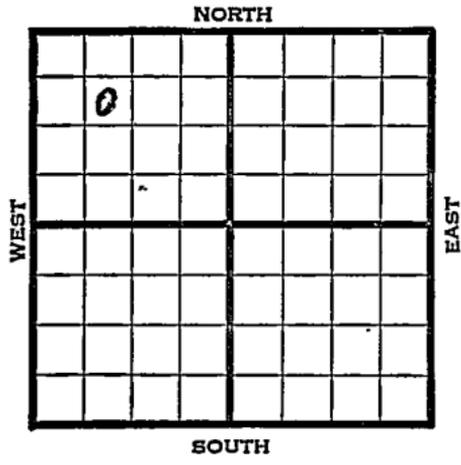

| 1941 | REPORT |
|------|---------------------------------|
| 1/8 | S. H. |
| 1/16 | 10" - 208' Drlg. 2782' |
| 1/23 | Arb. 3220-28' T.D. 6" - 3221' |
| | RUST. |
| 1/30 | Swab 226 oil & 3 water 3 hours. |
| | P.B. to 3227' |
| | |
| 2/5 | Arb. 3220' |
| | 6" - 3221' |
| | T.D. 3228' |
| | P.B. to 3227' |
| | Echometer potential 2270 bbls. |
| | plus 120 water. |
| | 40.1 Gravity |
| | COMPLETED |
| | |
| | |
| | |
| | |
| | |

Map No. 45 Sec. 19 Twp. 18 R. 7WWell No. 3 Hamilton "A"Continental Company

Contractor

FIRST REPORT

SE NW NW

SECTION PLAT

| | | | |
|--|--|--|--|
| | | | |
| | | | |
| | | | |
| | | | |

990 Ft. from N. Line

_____ Ft. from S. Line

_____ Ft. from E. Line

990 Ft. from W. Line

GENESEO POOL

Location _____

Rig up _____

Drilling and Remarks:

S. H.

RECORD

Cased _____ in., _____ ft.

Sand _____

Gas _____

Oil _____

Total Depth _____

PRODUCTION

1st 24 hrs. Nat. _____

1st 24 hrs. after shot _____

Gas _____ Cu. Ft.

Dry Hole _____

Abandoned _____

Date

JAN 8 1941 19S. J. LEWIS Scout

Map No. 45 Sec. 19 Twp. 18 R. 7WWell No. 3 Hamilton "A"Continental Company

Contractor

COMPLETED**SECTION PLAT**990 SE NW NW
Ft. from N. Line

____ Ft. from S. Line

____ Ft. from E. Line

990 Ft. from W. Line

| | | | |
|--|--|--|--|
| | | | |
| | | | |
| | | | |
| | | | |

GENESEO POOL

Location _____

Rig up _____

Drilling and Remarks:

*ca 83220**6" @ 3221**P.B 3227**Echo P 82270**Plus 120W.**40' G.L.***RECORD**

Cased _____ in., _____ ft.

Sand _____

Gas _____

Oil _____

Total Depth 3228**PRODUCTION**

1st 24 hrs. Nat. _____

1st 24 hrs. after shot _____

Gas _____ Cu. Ft.

Dry Hole _____

Abandoned _____

Date

FEB 5 1941 19

S. J. LEWIS

Scout