

KANSAS


Rice

FORM 51 5M 10-41 PETROL

Section 19 Township 18 Range 7-W

Well No. #4 Hamilton "A"

Company Continental

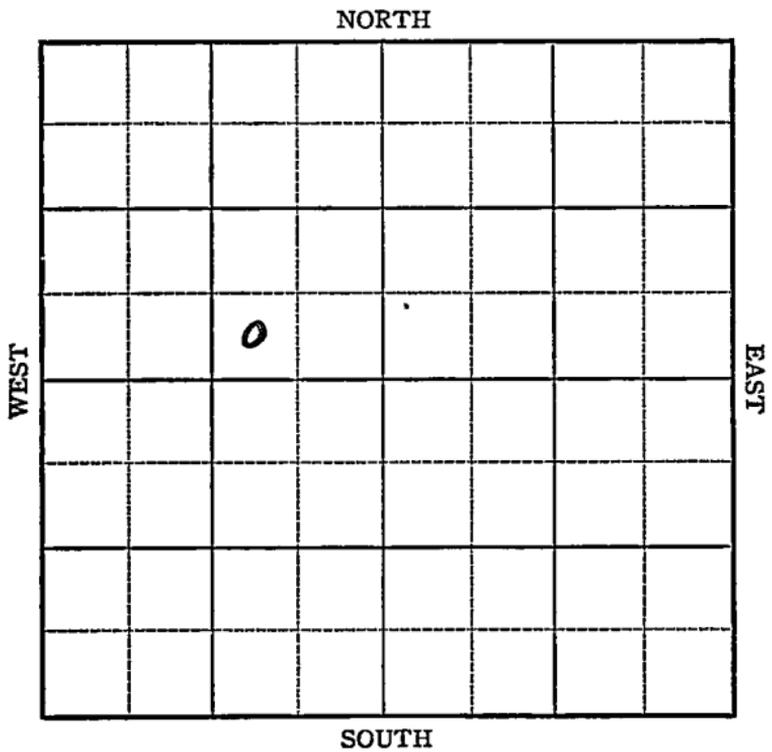

Sec. 19 Twp. 18 R. 7-W

Well No. #4 Hamilton "A" Farm

Continental Company

(Geneseo)


 Ft. from N. Line

330 Ft. from S. Line

990 Ft. from E. Line

 Ft. from W. Line

Elev. 1726

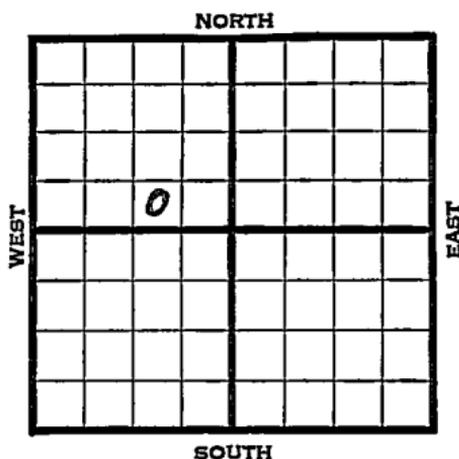

| | REPORT |
|------|--------------------------------|
| 1942 | |
| 5/6 | Rotary. |
| 5/13 | 10" - 203' Drlg. 1663' |
| 5/20 | Lans. 2790' Arb. 3197' |
| | T.D. 3200' 6" - 3198' RUST. |
| | |
| 5/27 | Arb. 3197' |
| | 6" - 3198' |
| | T.D. 3200' |
| | 2000 acid. |
| | Echometer potential 105l bbls. |
| | 39. Gravity |
| | |
| | COMPLETED |
| | |
| | |
| | |
| | |
| | |
| | |
| | |
| | |
| | |
| | |
| | |
| | |
| | |
| | |
| | |
| | |

Rice

KANSAS

Map No. 45 Sec. 19 Twp. 18 R. 7WWell No. 4 Hamilton "A"Continental

Company

FIRST REPORT

Contractor

SECTION PLAT

SW SE NW

| | | | |
|--|---|--|--|
| | | | |
| | | | |
| | o | | |
| | | | |
| | | | |

 Ft. from N. Line330 Ft. from S. Line990 Ft. from E. Line Ft. from W. Line

GENESEO POOL

Location Rig up

Drilling and Remarks:

Rotary

RECORD

Cased in., ft.Sand Gas Oil Total Depth

PRODUCTION

1st 24 hrs. Nat. 1st 24 hrs. after shot Gas Cu. Ft.Dry Hole Abandoned

Date

MAY 6 1942 19S. J. LEWIS Scout

Map No. 45 Sec. 19 Twp. 18 R. 7W

Well No. 4 Hamilton "A"

Continental Company

COMPLETED Contractor

SW SE NW

SECTION PLAT

_____ Ft. from N. Line

330 Ft. from S. Line

990 Ft. from E. Line

_____ Ft. from W. Line

| | | | |
|--|--|--|--|
| | | | |
| | | | |
| | | | |
| | | | |
| | | | |

GENESEO POOL

Location _____

Rig up _____

Drilling and Remarks:

*Co # 3197
6" @ 3198
2000 acid
Eched P # 1051*

39° SW

RECORD

Cased _____ in., _____ ft.

Sand _____

Gas _____

Oil _____

Total Depth 3200

PRODUCTION

1st 24 hrs. Nat. _____

1st 24 hrs. after shot _____

Gas _____ Cu. Ft.

Dry Hole _____

Abandoned _____

Date

MAY 27 1942 19

S. J. LEWIS Scout