

KANSAS


FORM 51 5M 1-42 PETROL

Rice

Section 19 Township 18 Range 7W

Well No. #1 Motter

Company Adair & Morton etal.
Semi-Wildcat

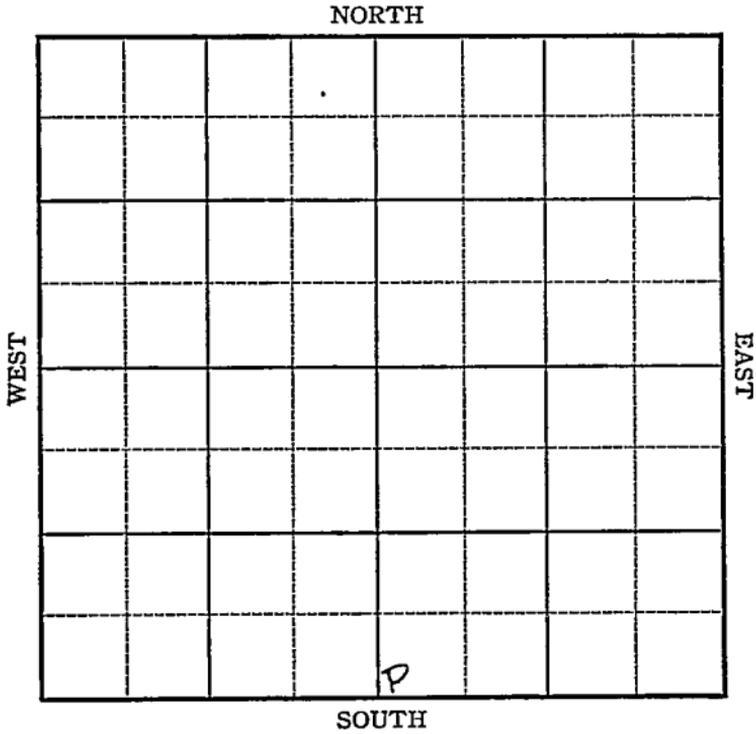

Sec. 19 Twp. 18 R. 7W

Well No. #1 Motter Farm _____

Adair & Morton etal Company _____

(Semi Wildcat)


_____ Ft. from N. Line

330 _____ Ft. from S. Line

_____ Ft. from E. Line

330 _____ Ft. from W. Line

Elev. 1693

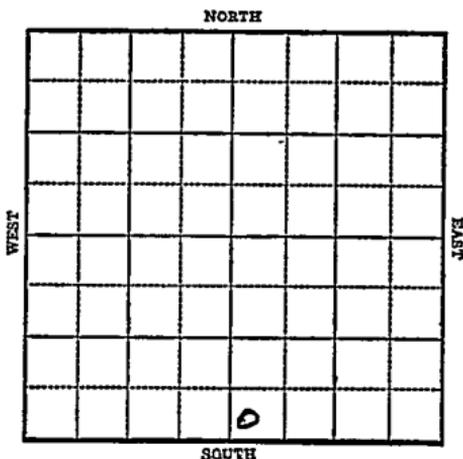

1942

R E P O R T

- 11/4 20" -20'
15" -305'
Drlg 485'
- 11/11 12" @ 1000'
Drlg. 1360'
- 11/18 Drlg. 1710
10" @ 1645
- 11/24 8" @ 2090 WOC
- 12/2 7" @ 2697
Lans 2775
Drlg. 2790
- 12/9 7" @ 2880
TD 291 8 HR 7"
- 12/16 TD 3190
Congl. 3111?
Simp 3138?
- 12/22 7" @ 3190'
Arb. 3250' TD
HFW SD
- 12/29 Arb. 3250
T.D. 3257'
HFW

ABANDONED

