


Kansas

Map No. _____ Sec. 36 Twp. 29 R. 25
 Well No. 12 Brown Farm _____
Lewis Oil Company _____

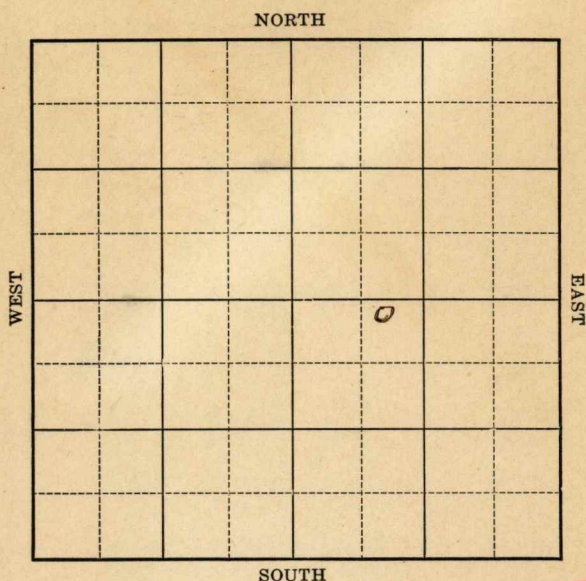

COMPLETED

Location _____

Rig Up _____

Drilling Remarks:

Drilling Remarks:

RECORD

Cased _____ in. _____ ft.

Sand _____

Gas _____

Oil _____

Total Depth _____

PRODUCTION

1st 24 hrs. Nat. _____

1st 24 hrs. after shot _____

Gas _____ cu. ft.

Dry Hole _____

Abandoned _____

Map No. _____ Sec. 36 Twp. 29 R. 5


Well No. #12 Brown Farm
Lewis Oil Company

250 Ft. from N. Line

_____ Ft. from S. Line

_____ Ft. from E. Line

960 Ft. from W. Line

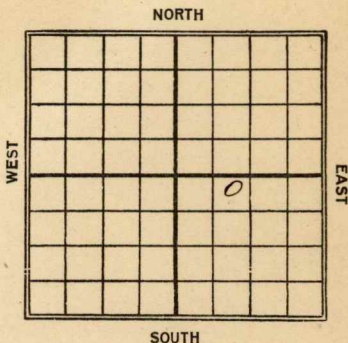

Date _____

REPORT

1922

7/22

9/16

Page up

D. 4 9. 27371

Map No. Kans 36 Sec. 29 Twp. 5Well No. 12 BrownLewis oil Company

Contractor

FIRST REPORT

SECTION PLAT

250 Ft. from N. Line250 Ft. from S. Line

Ft. from E. Line

960 Ft. from W. Line

		0	

Location

Rig up

Drilling and Remarks:

Rig up

RECORD

Cased _____ in., _____ ft.

Sand _____

Gas _____

Oil _____

Total Depth _____

PRODUCTION

1st 24 hrs. Nat. _____

1st 24 hrs. after shot _____

Gas _____ Cu. Ft.

Dry Hole _____

Abandoned _____

Date

JUL 22 1922

M. A. BENEAR

191

Scout

Map No. KANSAS 11 Sec. 36 Twp. 29 R. 5Well No. 12 BrownLewis oil Company

Contractor

ABANDONED

SECTION PLAT

250 Ft. from N. Line

Ft. from S. Line

Ft. from E. Line

960 Ft. from W. Line

Location

Rig up

Drilling and Remarks:

RECORD

Cased _____ in., _____ ft.

Sand _____

Gas _____

Oil _____

Total Depth _____

PRODUCTION

1st 24 hrs. Nat. _____

1st 24 hrs. after shot _____

Gas _____ Cu. Ft.

Dry Hole ✓Abandoned 2737

Date

SEP 16 1922 191

M. A. BENEAR

Scout