

Map No. **KANSAS** Sec. 34 Twp. 29 R. 5E


Well No. 1-Lanier Farm
Prairie & Leedy Company

330 Ft. from N. Line

_____ Ft. from S. Line

330 Ft. from E. Line

_____ Ft. from W. Line

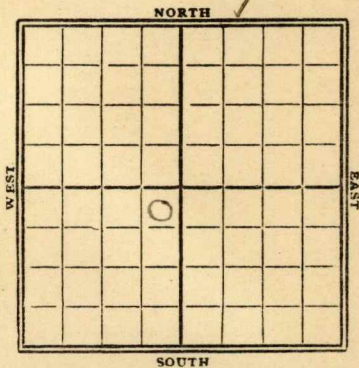

1929

Date

REPORT

Date	REPORT
8/21	Rig up
8/28	spdg 295
9/14	Wrlg 975'
9/14	" 1590'
9/18	VIR at 1910'
9/25	sety 8" - 2452'
10/2	Top line 2859 HFW 2985-90' Wrlg 3020'
10/9	Top line 2859 HFW 2985-90' Sile line 3249-58' T.D. 3258' HFW Dry & Abandon

Butler

Map No. 11 **KANSAS** Sec. 34 Twp. 29 R. 5^E

Well No. 1 Kanier

Prairie & Leedy Company
Contractor

FIRST REPORTS

SECTION PLAT

330 Ft. from N. Line

_____ Ft. from S. Line

330 Ft. from E. Line

_____ Ft. from W. Line

	0		

Location _____

Rig up

Drilling and Remarks:

RECORD

Cased _____ in., _____ ft.

Sand _____

Gas _____

Oil _____

Total Depth _____

PRODUCTION

1st 24 hrs. Nat. _____

1st 24 hrs. after shot _____

Gas _____ Cu. Ft.

Dry Hole _____

Abandoned _____

Date

8/21 1929

CHAS. L. SHERWOOD

Scout

Butler

Map No. **KANSAS** Sec. 34 Twp. 29 R. 5

Well No. 1 Lanier

Prairie & Leedy Company

Contractor

SECTION PLAT

COMPLETE

330 Ft. from N. Line

Ft. from S. Line

330 Ft. from E. Line

Ft. from W. Line

	0		

ABANDONED

Location

Rig up

Drilling and Remarks:

Jap lime 2859
HFW 2985-2990

Silc lime 3249-58

HFW

RECORD

Cased in., ft.

Sand

Gas

Oil

Total Depth 3258

PRODUCTION

1st 24 hrs. Nat.

1st 24 hrs. after shot

Gas Cu. Ft.

Dry Hole ✓

Abandoned ✓

Date

OCT 9 1929

CHAS. L. SHERWOOD

192 Scout