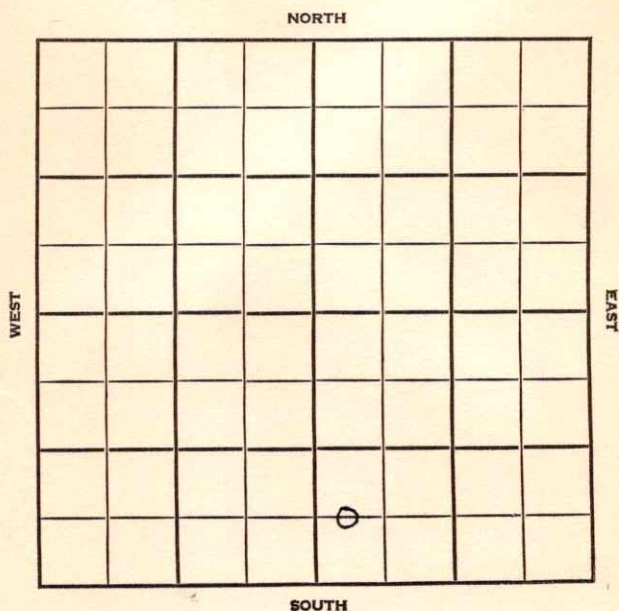


Section 13 Township 15 Range 14 WWell No. #1 Krug "C"Company Bennett & Roberts

Russell

KANSAS

SEC.	13	TWP.	15	R.	14W
------	----	------	----	----	-----

WELL NO.

#4 Krug "C"

FARM

COMPANY

Bennett & Roberts

CONTRACTOR

Co Tools


Trapp

Ft. from N. Line

Ft. from S. Line

Ft. from E. Line

Ft. from W. Line

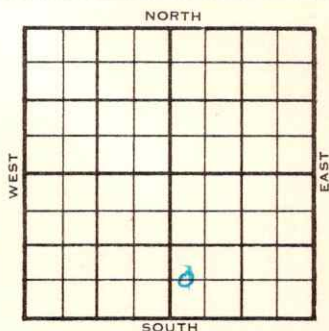C W $\frac{1}{2}$ SW SE

1955	ELEVATION 1892'	REPORT
------	--------------------	--------

10/5 Comm 9-27-55
8" @ 316/175
Drlg 2300

10/26 Comm 9-27-55
8" @ 316/175

Tp 2789
H 3021
Dodge 3038
L 3090
A 3358
TD 3375

DST 3122-32 open 1 hr Rec 30' mud
0/20"

D & A

ABANDONED

County Russell Elev. _____
 Sec. 13 Twp. 15 Rge. 14W
 Company Bennett & Roberts
 Farm Name Krug "C" No. 4

TOPS	DEPTH	LOG	DATUM
Anh.			
TP.			
H.			
Tr.			
Dg.			
BL.			
L.			
K.C.			
B.K.C.			
Ce.			
C.			
M.			
M.			
K.			
Mz.			
Mq.			
V.			
S.			
S.			
A.			
R.			
PE.			
G.			
T.D.			

Loc. in Sec. C W¹/₂ SW SE

Geol. _____

Contr. _____

Co. tools _____

Pool _____

Trapp _____

FIRST REPORT

OCT-5-35

0

Date Comm. 9-27-55
8" @ 316/175 drlg. 2300

~~13~~

County Russell Elev. 1892 Co. Co.
 Sec. 13 Twp. 15 Rge. 14W
 Company Bennett & Roberts
 Farm Name Krug "C" No. 4

TOPS	DEPTH	LOG	DATUM	Loc. in Sec.
Anh.				
Tp.	<u>2789</u>		<u>897</u>	<u>C W¹/₂ SWSE</u>
H.	<u>3021</u>		<u>1129</u>	
Tr. <u>Didge</u>	<u>3038</u>		<u>1146</u>	
Dg.				
Bl.				
L.	<u>3090</u>		<u>1198</u>	Geol.
K.C.				Contr.
B.K.C.				Co. tools
Ce.				
C.				Pool
M.				Trapp
M.				
K.				
Mz.				
Mq.				
V.				
S.				
S.				
A.	<u>3358</u>		<u>1466</u>	
R.				
Pe.				
G.				
T.D.	<u>3375</u>			

Date Comm. 9-27-55 OCT 2 6 1955

8" @ 316/175 DST 3122-32 open 1 hr.

Rec. 30' mud 0/20"

D & A