


KANSAS

Butler

Section 36 Township 29 Range 5-E

Well No. #3 Brown

Company Murfin Drlg

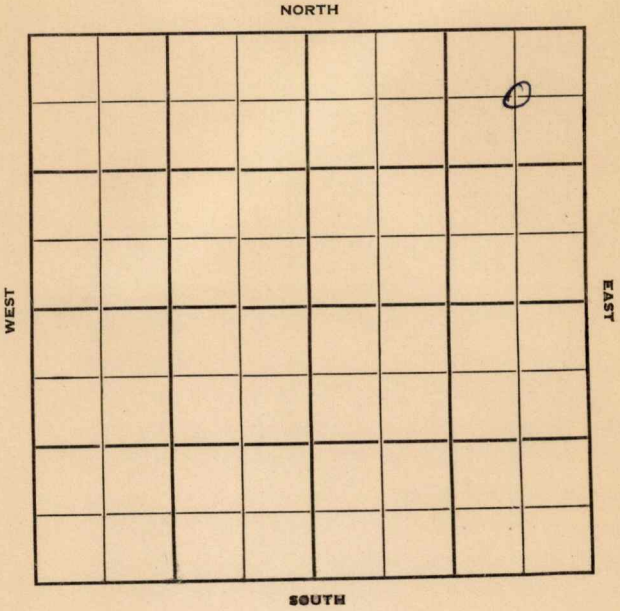

Butler
29

KANSAS
5E

Sec. 36 Twp. R.

Well No. #3 Brown Farm

Murfin Drlg. Company

Contractor

Miscellaneous


660' Ft. from N. Line

Ft. from S. Line

Ft. from E. Line

660' Ft. from W. Line

C NE NE

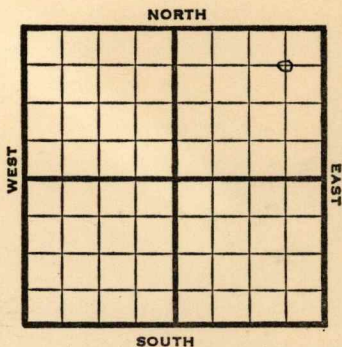

1950

REPORT

2/22

Spud 11-21-49

12" @ 690'

10" @ 1515'

8" @ 1895'

6" @ 2420'

5" @ 2765'

Bart. 2765'

TD 2810'

Comp. for 5 BOPD

FIRST REPORT
COMPLETED

Map No. _____ Sec. 36 Twp. 29 R. 5EWell No. 3 Brown

_____ Murfin Drlg. _____ Company

_____ Contractor

C NE NE

SECTION PLAT

660 Ft. from N. Line

_____ Ft. from S. Line

660 Ft. from E. Line

_____ Ft. from W. Line



Butler County

Location _____

Rig up _____

Drilling and Remarks:

Spud 11-21-49

12" @ 690

10" @ 1515

8" @ 1895

6" @ 2420

5" @ 2765

Bart. 2765

TD 2810

RECORD

Cased _____ in., _____ ft.

Sand _____

Gas _____

Oil _____

Total Depth _____

PRODUCTION

1st 24 hrs. Nat. _____

1st 24 hrs. after shot _____

Gas _____ Cu. Ft.

Dry Hole _____

Abandoned _____

Comp. for 5 BOPD

Date

FEB 22 1950 19

J. E. TYRA

Scout