


Section 19 Township 18 Range 7-W

Well No. #1 B. C. Gray

Company Continental

Geneseo Pool

NORTH

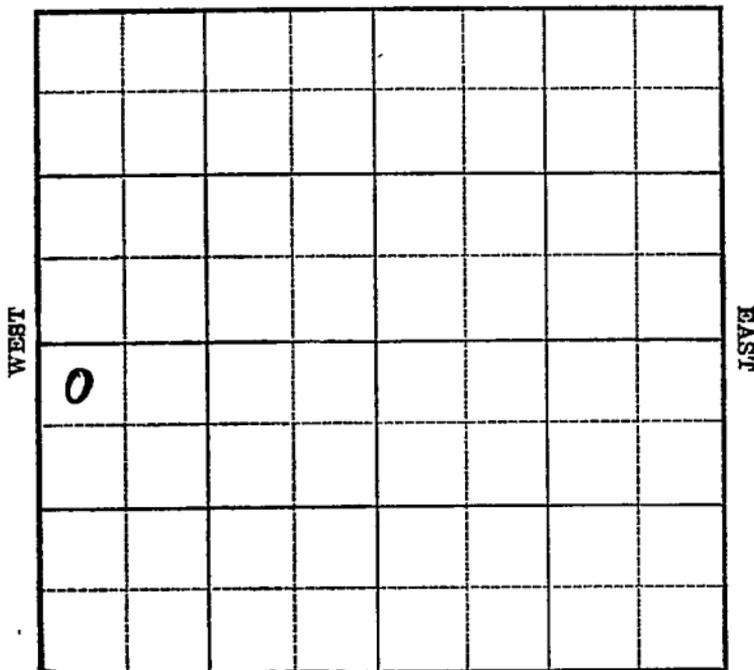

SOUTH

Sec. 19 Twp. 18 R. 7-W

Well No. #1 B. C. Gray Farm _____

Continental Company

(Geneseo)


330 Ft. from N. Line

_____ Ft. from S. Line

_____ Ft. from E. Line

330 Ft. from W. Line

Elev. 1696

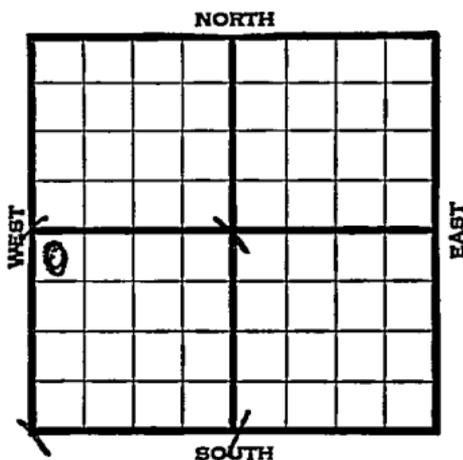

1939	REPORT
6/28	Rotary.
7/6	10" - 206' WOC.
7/13	Arb. 3098' T.D. 3107' Run 7".
7/20	7" - 3099' Drlg. 3116' 3000' oil.
7/27	T.D. 3136' 3000' oil. Run tubing.
8/2	Arb. 3098' 7" - 3099' T.D. 3136'
	Pump 2770 bbls., potential.
	COMPLETED

Map No. 45 Sec. 19 Twp. 18 R. 7WWell No. 1 B. C. GrayContinental

Company

Contractor

FIRST REPORT

SECTION PLAT

330 NW SW
Ft. from N. Line

Ft. from S. Line

Ft. from E. Line

330 Ft. from W. Line

6			

GENESEO POOL

Location _____

Rig up _____

Drilling and Remarks:

ROTARY

RECORD

Cased _____ in., _____ ft.

Sand _____

Gas _____

Oil _____

Total Depth _____

PRODUCTION

1st 24 hrs. Nat: _____

1st 24 hrs. after shot _____

Gas _____ Cu. Ft.

Dry-Hole: _____

Abandoned _____

Date

JUN 28 1939

19

S. J. LEWIS

Scout

Rice KANSAS

Map No. 45 Sec. 19 Twp. 18 R. 7W

Well No. I B. C. Gray

Continental

Company

Contractor

COMPLETED
NW SW

330 Ft. from N. Line

_____ Ft. from S. Line

_____ Ft. from E. Line

330 Ft. from W. Line

SECTION PLAT

0			

GENESEO POOL

Location _____

RECORD

Cased _____ in., _____ ft.

Sand _____

Gas _____

Oil _____

Total Depth 3186

PRODUCTION

1st 24 hrs. Nat. _____

1st 24 hrs. after shot _____

Gas _____ Cu. Ft.

Dry Hole _____

Abandoned _____

Rig up _____

Drilling and Remarks:

Oil 3098.

7" @ 3099

Pump. 2770 B.T.

Date

AUG 2 1939 19

S. J. LEWIS

Scout