Form 51—5M—11-38—Palace


Rice KANSAS

Section 19 Township 18 Range 7-W

Well No. #2 Hamilton "A"

Company Continental

Genneseo Pool

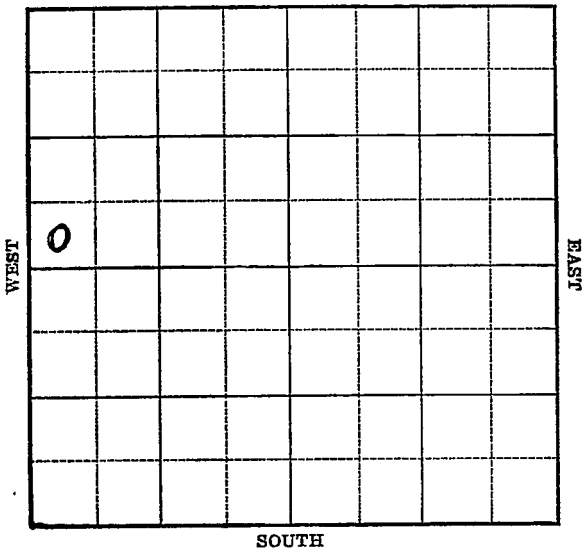

FORM 252-A 5M 4-39 KANSAS Rice

Sec. 19 Twp. 18 R. 7-W

Well No. #2 Hamilton "A" Farm

Continental Company


(Geneseo)

_____ Ft. from N. Line

330 Ft. from S. Line

_____ Ft. from E. Line

330 Ft. from W. Line

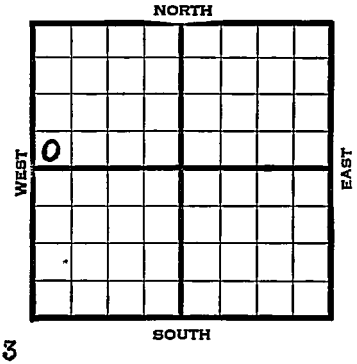

Elev. 1723

1939	REPORT
8/2	Rotary.
8/10	10" - 216' Drlg. 2650'
8/17	Arb. 3128' 7" - 3129'
	T.D. 3147' 2900' oil. Testing.
8/24	Drlg. 3192' 3000' oil in hole.
8/31	T.D. 3200' 3000' oil.
	Shut down.
9/7	" "
	- -
9/13	Arb. 3128'
	7" - 3129'
	T.D. 3200'
	2000 acid.
	Potential 2549 bbls., pump.
	COMPLETED

Form 26—1M Bks.—2-29 Rice KANSAS

Map No. 45 Sec. 19 Twp. 18 R. 7W

Well No. 2 Hamilton "A"

Continental Company

Contractor

FIRST REPORT

SW NW

____ Ft. from N. Line


330 Ft. from S. Line

____ Ft. from E. Line

330 Ft. from W. Line

GENESEO POOL

SECTION PLAT

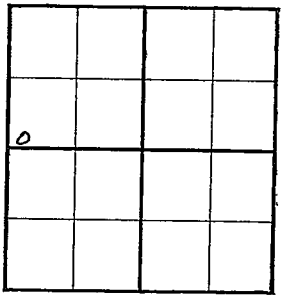

Location ____

Rig up ____

Drilling and Remarks:

ROTARY

RECORD

Cased ____ in., ____ ft.

Sand ____

Gas ____

Oil ____

Total Depth ____

PRODUCTION

1st 24 hrs. Nat. ____

1st 24 hrs. after shot ____

Gas ____ Cu. Ft.

Dry Hole ____

Abandoned ____

Date

AUG 2 1929 19 S. J. LEWIS Scout

Form 26—1M Bks.—2-29

Rice KANSAS

Map No. 45 Sec. 19 Twp. 18 R. 7W

Well No. 2 Hamilton "A"

Continental Company

Contractor

COMPLETED

SW NW

____ Ft. from N. Line


330 Ft. from S. Line

____ Ft. from E. Line

330 Ft. from W. Line

GENESEO POOL

SECTION PLAT

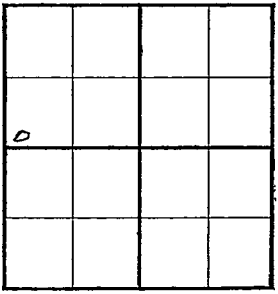

Location

Rig up

Drilling and Remarks:

Cir #3128

7" @ 3129

2000 acre

Pump 2549 B/F

RECORD

Cased ____ in., ____ ft.

Sand

Gas

Oil

Total Depth 3200

PRODUCTION

1st 24 hrs. Nat.

1st 24 hrs. after shot

Gas ____ Cu. Ft.

Dry Hole

Abandoned

Date

SEP 13 1939 19 J. LEWIS Scout