


Map No. _____ Sec. 36 Twp. 29 R. 5
Well No. 9 Brown _____ Farm
Lewis _____ Company

NORTH

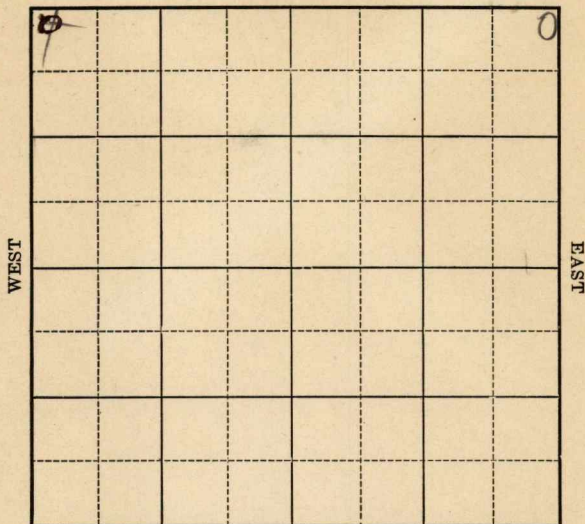

SOUTH

Location _____

Drilling Remarks:

Rig Up_____

Drilling Remarks:

RECORD

Cased _____ in. _____ ft.

Sand_____

Gas _____

Oil _____

Total Depth -----

PRODUCTION

1st 24 hrs. Nat. -----

1st 24 hrs. after shot-----


Gas -----cu. ft.

Dry Hole_____

Abandoned_ _ _ _ _

Map No. _____ Sec. 36 Twp. 29 R. 5

Well No. # 9 Brown Farm _____
Lewis Company _____

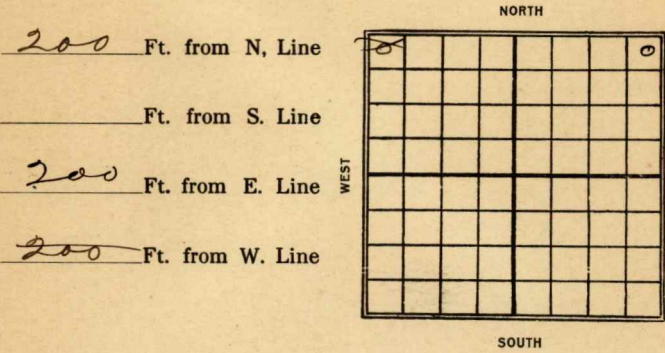

Date	REPORT
1922	
5/6	Rgn up
7/5	27#8- 74 TD
	15 Bbls nat

Map No. K11 Sec. 36 Twp. 29 R. 5Well No. 9 BrownLewis Company

Contractor

FIRST REPORT

SECTION PLAT

200 Ft. from N. Line

Ft. from S. Line

Ft. from E. Line

200 Ft. from W. Line

0			

Location

Rig up

Drilling and Remarks:

Rig up

RECORD

Cased _____ in., _____ ft.

Sand _____

Gas _____

Oil _____

Total Depth _____

PRODUCTION

1st 24 hrs. Nat. _____

1st 24 hrs. after shot _____

Gas _____ Cu. Ft.

Dry Hole _____

Abandoned _____

Date

MAY 6 1922


M. A. BENEAR

191

Scout

Map No. Gas 11 Sec. 36 Twp. 29 R. 5Well No. 9 Brown_____
Lewin Company_____
correct location Contractor

SECTION PLAT

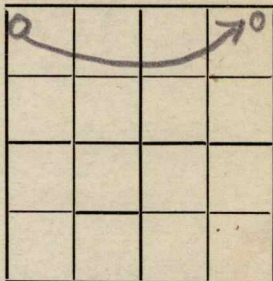200 Ft. from N. Line_____
Ft. from S. Line200 Ft. from E. Line_____
Ft. from W. Line**COMPLETED**

Location _____

Rig up _____

Drilling and Remarks:

15 ft
nat,**RECORD**

Cased _____ in., _____ ft.

Sand _____

Gas _____

Oil 2747-74Total Depth 2774**PRODUCTION**

1st 24 hrs. Nat. _____

1st 24 hrs. after shot _____

Gas _____ Cu. Ft.

Dry Hole _____

Abandoned _____

Date

JUL 15 1922_____
191M. A. BENEAR_____
Scout

Top 1600 - 3d
T₄ pay 1610'
60/175 lbs.

Returned

Cards

Tracing

J. S. C. map

Frantz map

Moody map

Frantz plat book

Moody plat book