


Section 13 Township 15 Range 14 W

Well No. # 4 Krug "F"

Company Cities Service

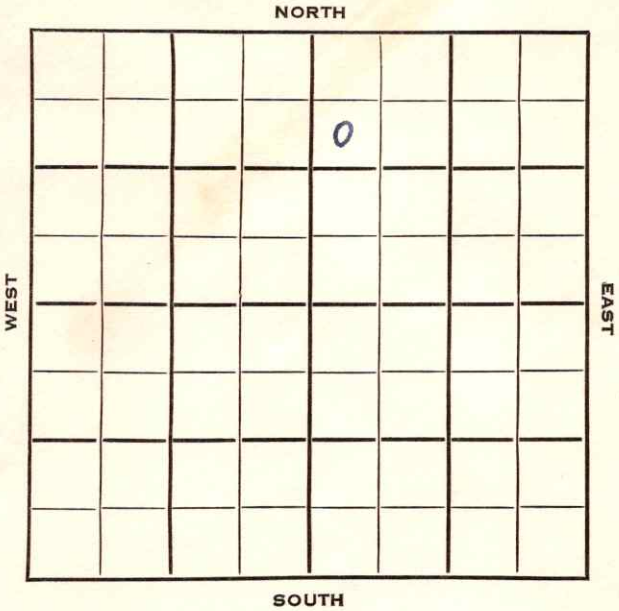

Russell

KANSAS

SEC.	13	TWP.	15	R.	14W ✓
------	----	------	----	----	-------

WELL NO. #4 Krug "F" FARM

COMPANY Cities Service

CONTRACTOR Barbour

Trapp Pool


990 Ft. from N. Line

Ft. from S. Line

Ft. from E. Line

330 Ft. from W. Line

SW NW NE

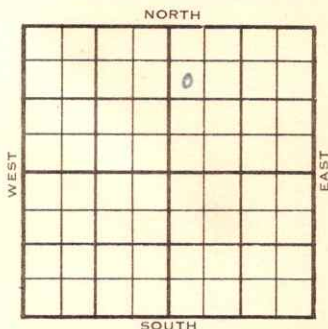

1953

ELEVATION

1892'

REPORT

10/28

Spud 10-22-53

8" @ 347'

Drlg 1730'

11/18

Spud 10-22-53

Oil Well

TD 3334'

8" @ 347'

Tarkio 2447', 2nd Tarkio 2462',

Heeb 3004', Dodge 3025', Lans 3070'

DST 3026'-40' opn 1 hr, rec 30' ocm
160#

DST 3090'-96' opn 1 hr, rec 20' mud
100#

DST 3102'-15' opn 1 hr, rec 33' socm

Arb 3327'

TD 3327'

5" @ 3328'

CO to 3328

DD 3334

500 A

Comp 68 bopd 83 bw.

COMPLETED

