Form 51-5M 5-37 Petrol


Russell

KANSAS

Section 13 Township 15 Range 14-W

Well No. 1 Krug "G"

Company Cities Service Co.

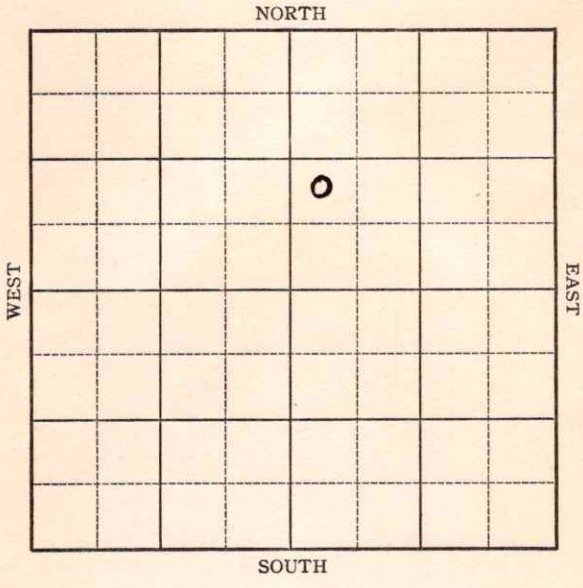


Form 252-A—5M—9-37 KANSAS Russell

Sec. 13 Twp. 15 R. 14-W

Well No. #1 Krug "G" Farm

Cities Service Oil Company

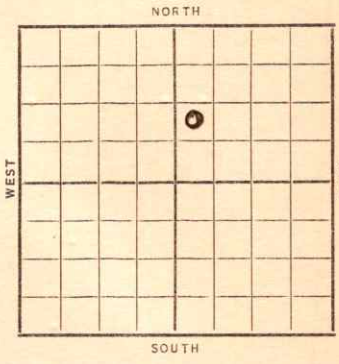

_____ Ft. from N. Line

990 Ft. from S. Line

_____ Ft. from E. Line

330 Ft. from W. Line

Elev. 1890

Date	REPORT
1937	
12/29	B. R.
1938	
1/7	12" @ 400'. WOC.
1/14	Drlg. 2545'.
1/20	K.C. 3077' T.D. 3093'
	No shows 8"-3093 R.U.S.T.
1/28	S.O. 3255-65'
	Coring.
2/3	1300' oil & 500' water @ 3289-92'
	7" - 3313' Cong. 3333'
	1800' water 3379-86'
	T.D. 3390' C.O.
2/11	Reworked Arb. 3392'.
	T.D. 3397'. 2400' water.
	P.B. 3313'.

OVER

1938

2/18 P.B. 3313'.
29 shots 3290-93'.
30 shots 3095-98'.
20 shots. 3106-09'.
2½ BW & 1/2 bailer oil per hour
5000 acid. Swabbing 6 oil &
2 water per hour.

2/26 1600' oil in hole & 1 BWPH

3/2 K.C. 3077'.
Reworked Arb. 3392'.
T.D. 3397'.
2400' water.
P.B. 3313'.
Perforated pipe 3290-93; 3106-09
and 3095-98'.
10,000 acid.
Potential 949 oil & 4% water.

COMPLETED

Form 26—1M Bks.—2-29 Russell KANSAS

Map No. 73 Sec. 13 Twp. 15 R. 14W

Well No. 1 Krug "G"

Cities Service Oil Company

Contractor

FIRST REPORT

NW SW NE


Ft. from N. Line

990 Ft. from S. Line

Ft. from E. Line

330 Ft. from W. Line

SECTION PLAT

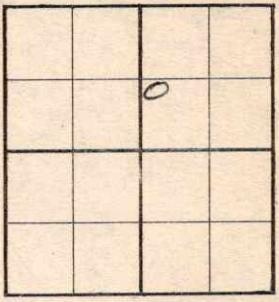

Location

Rig up

Drilling and Remarks:

BR

RECORD

Cased in., ft.

Sand

Gas

Oil

Total Depth

PRODUCTION

1st 24 hrs. Nat.

1st 24 hrs. after shot

Gas Cu. Ft.

Dry Hole

Abandoned

Date

DEC 29 1937 19

H. D. Hatfield Scout

Form 26—1M Bks.—2-29

Russell KANSAS

Map No. 73 Sec. 13 Twp. 15 R. 14W

Well No. 1 Krug "G"

Cities Service Oil Company

Contractor

COMPLETED

NW SW NE


Ft. from N. Line

990 Ft. from S. Line

Ft. from E. Line

330 Ft. from W. Line

SECTION PLAT

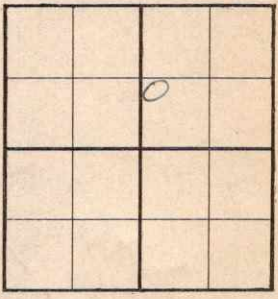

Location

Rig up

Drilling and Remarks:

P.B. 3313
Perforated Pipe
3290-93; 3106-09
3095-98
10,000 Acid
POT 949 oil
4 070 WTR

RECORD

Cased in., ft.

~~Sand~~ KC 3077
Reworked Arb 3392

Gas

Oil

Total Depth 3397 2400 WTR

PRODUCTION

1st 24 hrs. Nat.

1st 24 hrs. after shot

Gas Cu. Ft.

Dry Hole

Abandoned

Date

MAR 2 - 1938 19

H. D. Hatfield Scout