

Section 13 Township 15 Range 14 WWell No. # 5 TittleCompany B & R Drlg.

	0						

NORTH

WEST

EAST

SOUTH

Russell			KANSAS
SEC.	TWP.	R.	
13	15	14W	✓

WELL NO. #5 Tittle FARM

COMPANY

B & R Drlg.

CONTRACTOR

B & R Drlg.


Trapp Pool

990 Ft. from N. Line

Ft. from S. Line

Ft. from E. Line

990 Ft. from W. Line

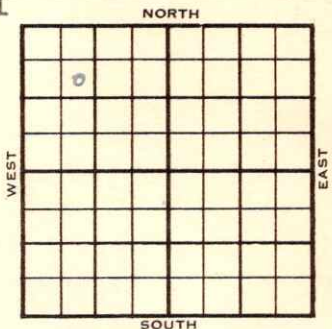

SE NW NW

	ELEVATION	REPORT
1953	1890'	

10/14 Spud 10-7-53
8" @ 351'
Drlg 2765'

10/21 Heeb 3025' Lans 3089' Arb. 3357
RTD 3627' 5" @ 3627 SWD

10/28 NR

11/4 NR

11/11 "

11/18 "

12/2 Spud 10-7-53

SWD Well

TD 3627

8" @ 351'

Heeb 3025', Arb. 3357'

TD 3627

5" @ 3627

Lans 3089'

5" @ 3537'

TD 3627

Comp. for SWD Well

ABANDONED

County Russell State KansasSec. 13 (Blk.) 15 (Sur. Rge.) 14W Map No.Operator B & R Drlg.Well No. 5 Farm TittleElev. Location SE NW NW

	0						


990 Ft. From N Line NW990 Ft. From W Line Quarter1st. Report OCT 14 1953

Completion

Remarks

B & R Drlg. - Contr.Spudding Date 10-7-53Drlg. Data Trapp Pool8" @ 351 drlg. 2765

County Russell State Kansas
 Sec. 13 (Blk. 15) (Sur. 14W) (Rge.) Map No.
 Operator B & R Drlg.
 Well No. 5 Farm Tittle
 Elev. 1890 Location SE NW NW

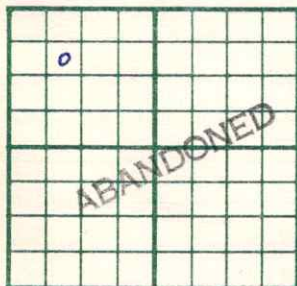

990 Ft. From N Line NW
990 Ft. From W Line Quarter
 1st. Report
 Completion DEC 2 1953
 Remarks Trapp Pool
B & R Drlg. - Contr.
 Spudding Date 10-7-53

Drlg. Data SWD well TD 3627
8" @ 351 Heeb. 3025 Arb. 3357
TD 3627 5" @ 3627 Lans. 3089
5" @ 3537 TD 3627
Comp. for SWD well

J. G. McCLURE