

KANSAS

Form 51—5M—7-39—Palace

Russell

Section 35 Township 15 Range 14-W


Well No. #4 Phillip Ochs

Company Mid-Cont. Petr. Corp.

NORTH

Trapp Pool

WEST

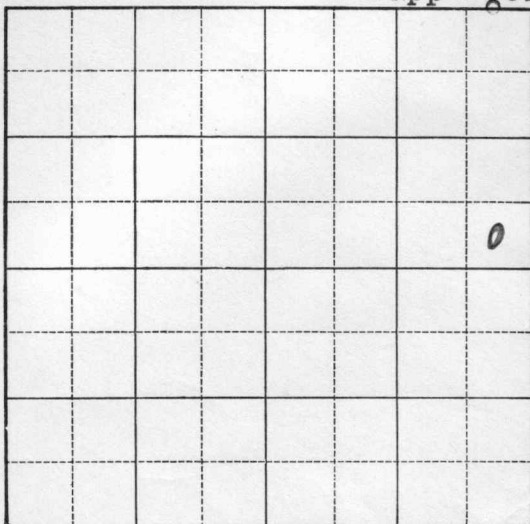

EAST

SOUTH

KANSAS

Russell

Sec. 35 Twp. 15 R. 14-W

Well No. #4 Ochs Farm

Mid-Continent Petr. Company
(Trapp Pool) NORTH


Ft. from N. Line

330 Ft. from S. Line

330 Ft. from E. Line

Ft. from W. Line

Elev. 1896

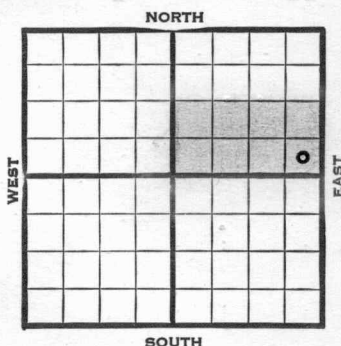

1940	REPORT
5/10	Location (Location notice)
5/14	Building derrick ✓ (Tel)
5/17	Derrick up Waiting on tools (Tel)
5/20	Rig (Tel)
5/23	"
5/24	" (Tel)
5/25	Rig Waiting on tools from #3 Rogg (Tel)
5/29	Rigging up rotary.
6/1	Dlg. 1700 (Tel)
6/3	Dlg. 2240 (Tel)
6/5	Dlg. 2500 Will core Saturday or Sunday (Tel)
6/6	10" - 338' Drlg. 2510'
6/7	Will start coring tonight for top Arbuckle (Tel)
	OVER

1940

6/9--Cored 3319-28 Recovered 9 feet
Top Arbuckle 3323 Core showed good
porosity and well stained with oil
T.D. 3328 Running 7" 3323 (Tel)

Running 1' lower on Arbuckle than Coralena #11
(east offset) which filled up 2850' oil
1½ hrs. after drilling plug

Running 5' higher than our #3 Ochs north offset
completed for depthograph potential 5366 bbls

Running 3' higher than Coralena #8 diagonal
northeast a 15 bbl. minimum well

6/13--Will drill in this morning (Tel)

6/14--After drilling plug filled up 600 feet
oil in 1/2 hour Hole very muddy
While cleaning out and coring to total
depth 3331 total fill up 2800 feet oil
in 8 hours Cleaning out
Will take swabbing test this afternoon
(Tel)

6/15--T.D. 3331 Swabbed 50 bbls. per hour for
5 hours Swabbing 800 feet off bottom
Will run tubing and acidize (Tel)

6/18--Depthograph potential 1384 bbls.
Shale break cave in shut off part of oil
(Much better well than potential shows)

6/19 Arb. 3323'
7" - 3323'
T.D. 3331'
2000 acid.
Depthograph potential 1384 bbls.

COMPLETED

6/22--Corrected potential is 1342 bbls.
(Letter)

Map No. 73 Sec. 35 Twp. 15 R. 14WWell No. 4 Phillip OchsMid-Continent Petroleum Corp
Company

Contractor


FIRST REPORT

SE NE

 Ft. from N. Line330 Ft. from S. Line330 Ft. from E. Line Ft. from W. Line

TRAPP POOL

SECTION PLAT

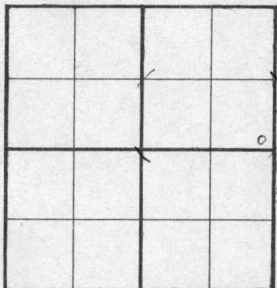Location Rig up Drilling and Remarks:
Derrick

RECORD

Cased in., ft.Sand Gas Oil Total Depth

PRODUCTION

1st 24 hrs. Nat. 1st 24 hrs. after shot Gas Cu. Ft.Dry Hole Abandoned

Date

MAY 15 1940

19

S. J. LEWIS Scout

Map No. 73 Sec. 35 Twp. 15 R. 14WWell No. 4 Phillip Ochs

Mid-Continent Petroleum Company

Contractor

COMPLETED

SE NE


_____ Ft. from N. Line

330 Ft. from S. Line330 Ft. from E. Line

_____ Ft. from W. Line

TRAPP POOL

SECTION PLAT

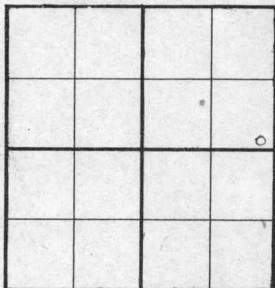

Location _____

Rig up _____

Drilling and Remarks:

*Ch & 3323**7" @ 3323**2000 acid**Depthograph P.O.**1384*

RECORD

Cased _____ in., _____ ft.

Sand _____

Gas _____

Oil _____

Total Depth 3331

PRODUCTION

1st 24 hrs. Nat. _____

1st 24 hrs. after shot _____

Gas _____ Cu. Ft.

Dry Hole _____

Abandoned _____

Date

JUN 19 1940 19S. J. LEWIS Scout