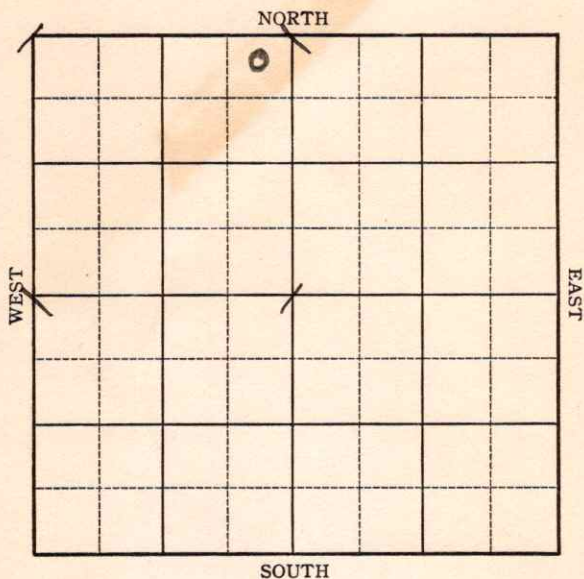


Russell

Section 13 Township 15 Range 14-WWell No. 1 Tittel "C"Company Cities Service Oil

1938

2/2 8" @ 3091'.

K.C. 3074' (Corrected)

T.D. 3125'.

10,000 acid.

Potential 1328 bbls.

COMPLETED

Russell

KANSAS

Map No. _____ Sec. 13 Twp. 15 R. 14WWell No. 1 Tittel "C"

Cities Service Oil Company

Contractor _____

FIRST REPORT

NE NW


330 Ft. from N. Line

_____ Ft. from S. Line

330 Ft. from E. Line

_____ Ft. from W. Line

SECTION PLAT

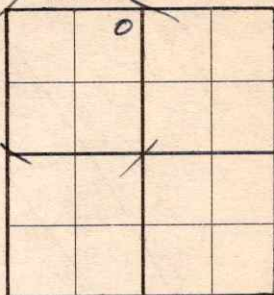

Location _____

Rig up _____

Drilling and Remarks:

BRR

RECORD

Cased _____ in., _____ ft.

Sand _____

Gas _____

Oil _____

Total Depth _____

PRODUCTION

1st 24 hrs. Nat. _____

1st 24 hrs. after shot _____

Gas _____ Cu. Ft.

Dry Hole _____

Abandoned _____

Date

DEC 8 - 1937 19 H. D. Hatfield Scout

KANSAS

Russell

Map No. _____ Sec. 13 Twp. 15 R. 14WWell No. 1 Tittel "C"Cities Service Oil Company

Contractor _____

COMPLETED

NE NW

330 Ft. from N. Line

_____ Ft. from S. Line

330 Ft. from E. Line

_____ Ft. from W. Line

SECTION PLAT

	0		

Location _____

Rig up _____

Drilling and Remarks:

10,000 and
POT 1328

RECORD

Cased 8 in., 3091 ft.Sand K.C. 3074Gas (corrected)

Oil _____

Total Depth 3125

PRODUCTION

1st 24 hrs. Nat. _____

1st 24 hrs. after shot _____

Gas _____ Cu. Ft.

Dry Hole _____

Abandoned _____

Date

FEB 2 1938 19 H. D. Hatfield Scout