


Rice

KANSAS

Section 23 Township 18 Range 7W

Well No. #1 Fuller

Company Trans-Era

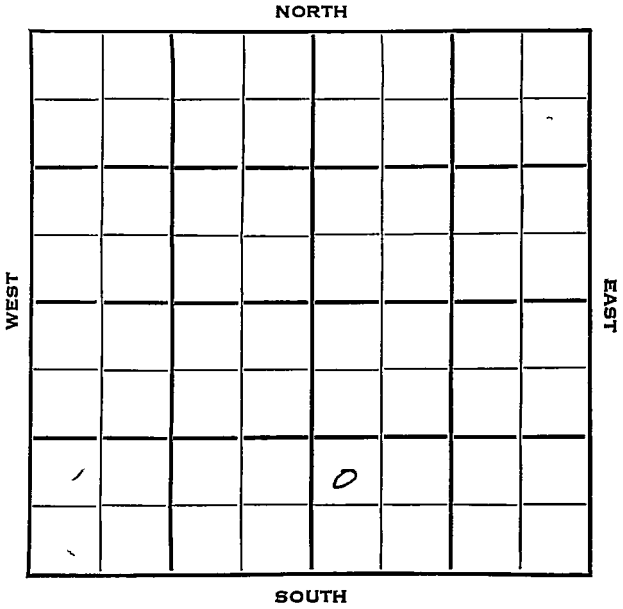

Sec. 23 Twp. 18 R. 7 W

Well No. # 1 Fuller Farm

Trans-Era Company

Trans-Era Contractor


Ft. from N. Line

990 Ft. from S. Line

Ft. from E. Line

330 Ft. from W. Line

NW SW SE

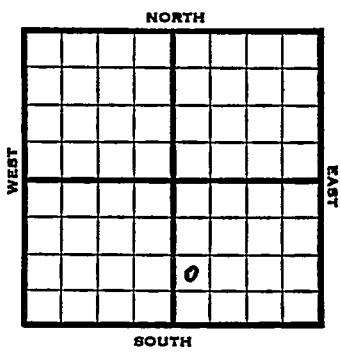

1953 Elev. 1686 ' REPORT

3/11 8" @ 190

3/19 Drlg. 256 1/2'

3/26 D&A

4/1
 D & A
 TD 3245'
 8" @ 190
 DST 3161-66
 open 1/2 hr. Rec 150' gcm
 TD 3245
 Lans 2780, Gong 3209
 D & A

ABANDONED

