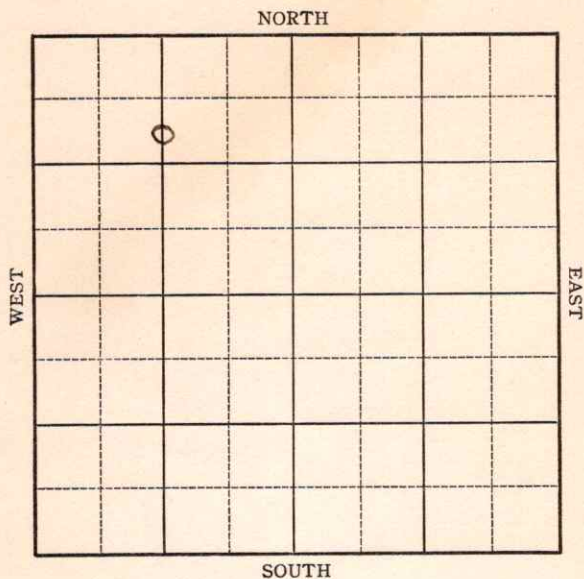



KANSAS

Russell

Section 13 Township 15 Range 14-WWell No. 2 Tittel "C"Company Cities Service Oil

Sec. 13 Twp. 15 R. 14-WWell No. #2 Title "C" FarmCities Service Oil Company990 Ft. from N. Line Ft. from S. Line Ft. from E. Line1320 Ft. from W. Line

Elev. 1894'.

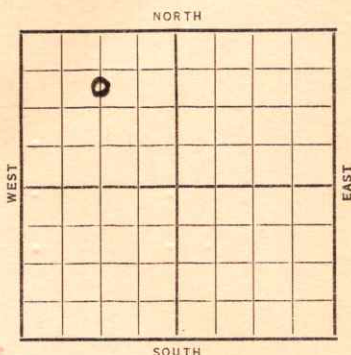

Date

REPORT

1938

1/12

R U R

1/20

12" - 350' Drlg. 644'

1/28

Drlg. 2465'

2/4

K.C. 3085' Drlg. 3130'

2/11

Arb. 3350'. T.D. 3354'.

7" @ 3351'. S.O. RUST.

2/18

T.D. 3357'. 1000 acid.

Pump 25 oil & 5 wtr. in 2 hrs.

2/26

Potential 113 oil & 120 water.

S. D. O.

3/4

T.D. 3357' S.D.O.

3/11

" " "

3/18

" " "

3/25

" " "

4/1

" " "

OVER

1938

4/6 7" @ 3351'.

Arb. 3350'.

T.D. 3357'.

Potential 113 oil & 120 water.

COMPLETED

Map No. 73 Sec. 13 Twp. 15 R. 14WWell No. 2 Tittel "C"

Cities Service Oil

Company

Contractor

FIRST REPORT

C S L N $\frac{1}{2}$ NW990 Ft. from N. Line

_____ Ft. from S. Line

_____ Ft. from E. Line

1320 Ft. from W. Line

SECTION PLAT

0			

Location _____

Rig up _____

Drilling and Remarks:

RUR

RECORD

Cased _____ in., _____ ft.

Sand _____

Gas _____

Oil _____

Total Depth _____

PRODUCTION

1st 24 hrs. Nat. _____

1st 24 hrs. after shot _____

Gas _____ Cu. Ft.

Dry Hole _____

Abandoned _____

Date

JAN 12 1938

19

H. D. Hatfield Scout

Russell

KANSAS

Map No. 73 Sec. 13 Twp. 15 R. 14WWell No. 2 Tittel "C"

Cities Service Oil

Company

Contractor

COMPLETED

C S L N $\frac{1}{2}$ NW990 Ft. from N. Line

Ft. from S. Line

Ft. from E. Line

1320 Ft. from W. Line

SECTION PLAT

0			

Location

Rig up

Drilling and Remarks:

POT 113 oil
120 WTR

RECORD

Cased 7 in., 3351 ft.Sand Arb 3350

Gas

Oil

Total Depth 3357

PRODUCTION

1st 24 hrs. Nat.

1st 24 hrs. after shot

Gas Cu. Ft.

Dry Hole

Abandoned

Date

APR 6 - 1938

19

H. D. Hatfield

Scout