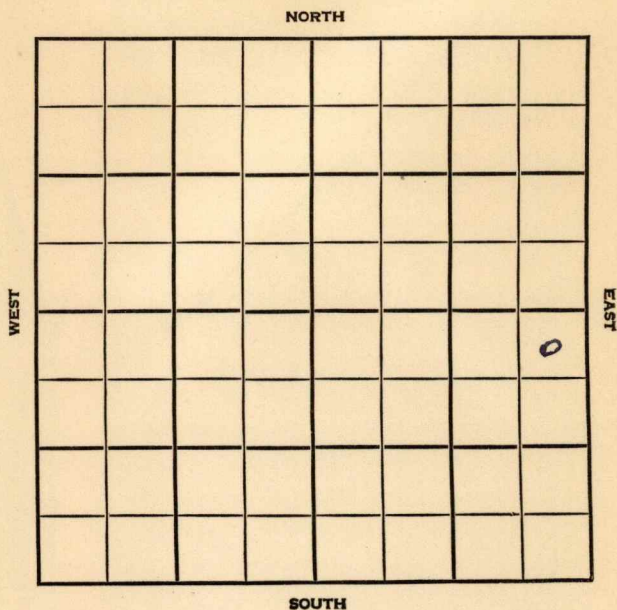


Section 36 Township 29 Range 5 EWell No. 1 Warren Brown "B"Company Stelbar Oil

Butler

KANSAS

SEC.	TWP.	R.
36	29	5E

WELL NO.

#1 Warren Brown "B"

FARM

COMPANY

Stelbar Oil

CONTRACTOR

McKnab & Lindsay

Fox-Bush Pool

NORTH

330


Ft. from N. Line

Ft. from S. Line

330

Ft. from E. Line

Ft. from W. Line

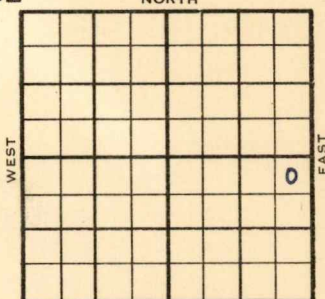

NE NE SE

SOUTH

1954

ELEVATION

1339'

REPORT

12/22

MIR

1955

1/26

Spud 12-21-54

Oil well TD 2817 8" @ 83

Bart. 2771 TD 2805 5" @ 2782

DD 2817 frac.

Comp. 20 BOPD

COMPLETED

FABEN GILSTRAP