


Section 2 Township 29 Range 6E

Well No. #1 Frankson

Company Bennett & Abels

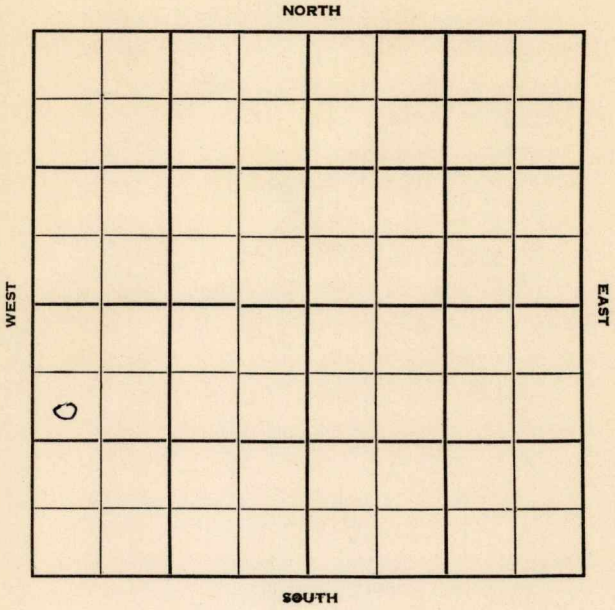

Butler

KANSAS

Sec. 2 Twp. 29 R. 6E

Well No. #1 Frankson Farm

Bennett & Abels Company

Saco - Contr. Contractor


990' Ft. from N. Line

Ft. from S. Line

Ft. from E. Line

330' Ft. from W. Line

SW NW SW

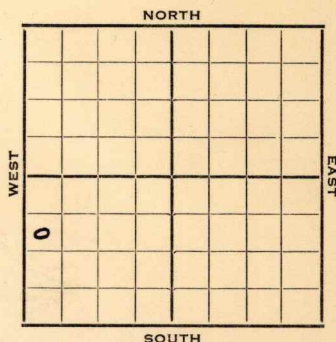

1952

Elev. 1432'

REPORT

3/19
5/7

MICT

Spud 3-28-52

D&A TD 2890'

15" @ 350' 13" @ 1016'

10" @ 1660'

Lans. 1765

KC 2150

8" @ 1660'

Miss. 2838

Bart. 2755'

TD 2890 D&A

ABANDONED

County **Butler** State **Kansas**
 Sec. **2** (Blk. **29** (Sur. **6E** Map No.

Sec. 2 (Blk.) 29 (Sur.) 6E Map No.

Operator Bennett & Abels

Well No. 1 Farm Franks on

Elev.	Location	SW	NW	SW
-------	----------	----	----	----

990 Ft. From N Line SW

330 Ft. From W Line Quarter

1st. Report MAR 19 1952

Completion

Remarks

Saco - Contr.


Spudding Date

Drlg. Data

M I C T

J. G. McGEHEE

County Butler State Kansas
 Sec. 2 (Blk. 29 (Sur. 6 E Map No.)
 (Twp.) (Rge.)
 Operator Bennett & Abel
 Well No. 1 Farm Frankson
 Elev. 1432 Location SW NW SW

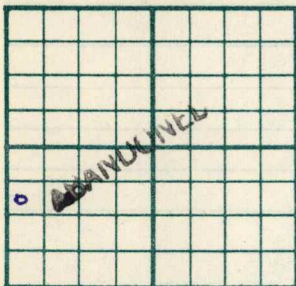

990 Ft. From N Line SW
330 Ft. From W Line Quarter

1st. Report

Completion MAY 7 1952

Remarks

Saco - Contr.

Spudding Date 3-28-52

Drlg. Data D & A TD 2890

15" @ 350 13" @ 1016 10" @ 1660

Lans. 1765 KC 2150 8" @ 2372

Miss. 2838 Bart. 2755 TD 2890

D & A

J. G. McGEHEE