

Section 15 Township 34 Range 3EWell No. #2 SnyderCompany Aladdin Pet.

NORTH

4

	0						

SOUTH

WEST

EAST

Cowley
34

KANSAS

Sec. 15 Twp. 34 R. 3E

Well No. #2 Snyder Farm

Aladdin Petr. Company

Crowe Drlg. Contractor


990 Ft. from N. Line

Ft. from S. Line

Ft. from E. Line

990 Ft. from W. Line

SE NW NW

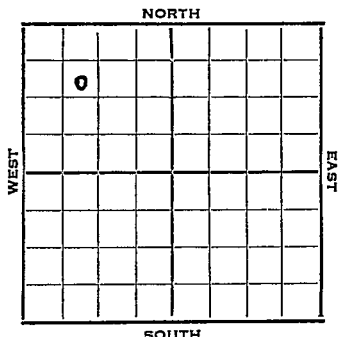

1953 Elev. 1089' REPORT

2/4 Cellar & Pits

2/25 Spud 2-6-53
Oil Well
TD 3297
8" @ 133
Stal 2122, Layton 2581, KC
2784, Marm 2974, Bart 3273,
TD 3297
5" @ 3275
CO to 3297
PB 3292
FU 100' oil 14 hrs., Hydro
F/200 bo 5 hrs.
Comp. BHB 1798 bopd

COMPLETED

County Cowley State Kansas

Sec. 15 (Blk. Twp.) 34 (Sur. Rge.) 3E Map No.

Operator Aladdin Pet.

Well No. 2 Farm Snyder

Elev.	Location	SE	NW	NW
-------	----------	----	----	----

0

FIRST REPORT

990 Ft. From N Line NW

990 Ft. From ~~the~~ Line Quarter

1st. Report FEB 4 1953

Completion


Remarks

Crowe Drle. - Contr.

Spudding Date

Drlg. Data

Cellar & pits

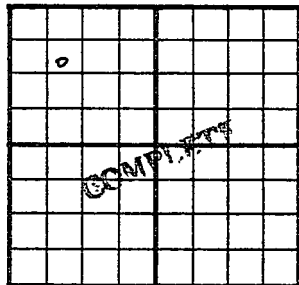County Cowley State KansasSec. 15 (Blk.
Twp.) 34 (Sur.
Rge.) 3E Map No. _____Operator Aladdin Pet.Well No. 2 Farm SnyderElev. 1089 Location SE NW NW990 Ft. From N Line NW990 Ft. From W Line Quarter

1st. Report _____

Completion FEB 25 1953

Remarks _____

Crowe Drlg. - Contr.Spudding Date 2-6-53Drlg. Data Oil well TD 32978" @ 133 Stal. 2122 Layton 2581KC 2784 Marm. 2974 Bart. 3273TD 3297 5" @ 3275 CO to 3297PB 3292 FU 100' oil 14 hr. Hydro.200 bopd 5 hr. Comp. HIB 1798 bopd

J. G. McGEHEE