


Section 15 Township 34 Range 3E

Well No. 3⁶ Snyder

Company McNish & Grallop

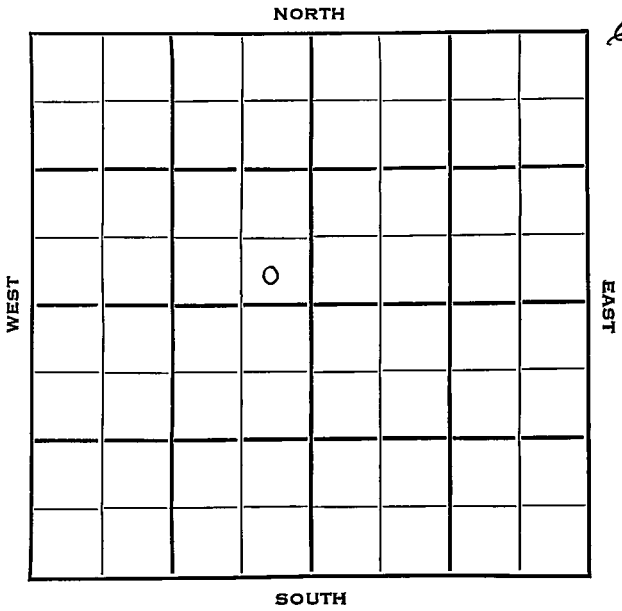

Sec. 15 Twp. 34 R. 3E

Well No. #3 Snyder Farm

McNish & Grallop Company

Watson Drlg. Contractor

Harvey Pool


_____ Ft. from N. Line

330 Ft. from S. Line

330 Ft. from E. Line

_____ Ft. from W. Line

SE SENW

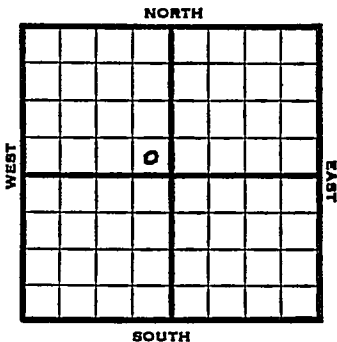

1953

Elev. 1087' REPORT

4/8

Spud 4-6-53
Drlg. 100'

5/6

Spud 4-6-53
Oil Well
TD 3298'
10" @ 90'
Bart 3270
TD 3298
7" @ 3298'
49/ 3273-91 FU 500' oil 18 hr.
sd-frac Comp. 2121 bopd.

COMPLETED

