

Sec. 2 Twp. 29 Range 6 E

1 Frankson

Kansas Geological Society


Oto Oil

Skelly Scout Tickets

Map No. XIII Sec. 2 Twp. 29 R. 6Well No. 1 Frankson FarmOtto Ors Company

NORTH

WEST

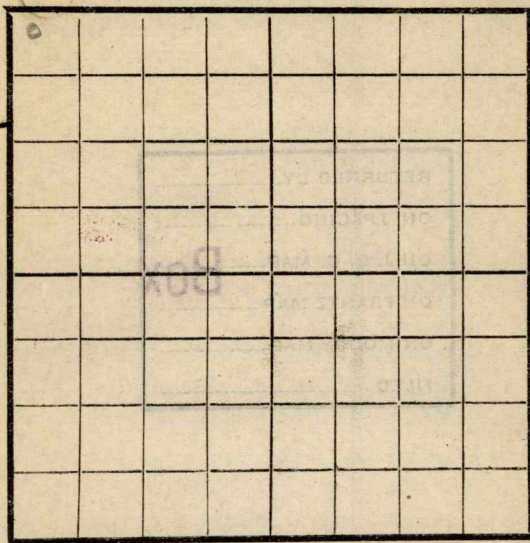

EAST

SOUTH

Location -----

Rig Up -----

Drilling and remarks -----

RECORD

Cased ----- in. ----- Ft.

Sand -----

Gas -----

Oil -----

Total Depth -----

PRODUCTION

1st 24 hrs. Nat. -----

1st 24 hrs. after shot -----

Gas ----- Cu. Ft.

Dry Hole -----

Abandoned -----

FIRST REPORT

Date

4/30, 1918 C. Ors Scout

Map No. _____ Sec. 2 Twp. 29 R. CWell No. 1 Frankson Farm
oto oil Company

NORTH

WEST

EAST

SOUTH

Location _____

Rig Up _____

Drilling and remarks

Rigging
Waymeyer
Drilling Co
Douglas K

RECORD

Cased _____ in. _____ Ft.

Sand _____

Gas _____

Oil _____

Total Depth _____

PRODUCTION

1st 24 hrs. Nat. _____

1st 24 hrs. after shot _____

Gas _____ Cu. Ft.

Dry Hole _____


Abandoned _____

Date

5/22, 1918 *Candey* Scout

Map No. _____ Sec. 2 Twp. 29 R. 6
Well No. 1 Thompson
Otoe _____ Company


Contractor

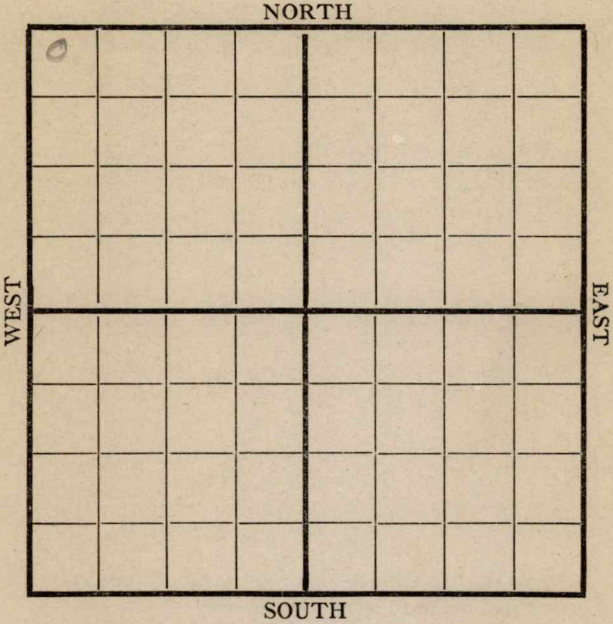

Location _____ Rig up _____ Drilling and Remarks: <u>340</u>	RECORD
	Cased _____ in., _____ ft. Sand _____ Gas _____ Oil _____ Total Depth _____ PRODUCTION 1st 24 hrs. Nat. _____ 1st 24 hrs. after shot _____ Gas _____ Cu. Ft. Dry Hole _____ Abandoned _____

Date 6/12 1912 S. Carley Scout

Map No. _____ Sec. 2 Twp. 29 R. 6
Well No. 1 Frankson
Oto Oil Company _____
Contractor _____

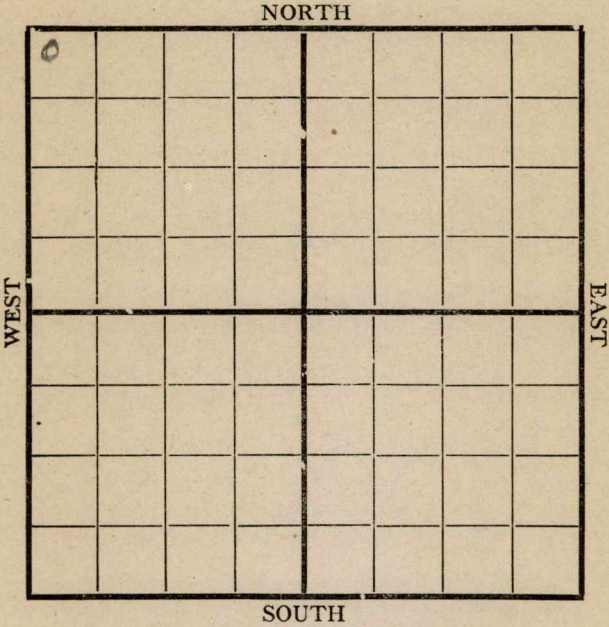

Location _____ Rig up _____ Drilling and Remarks: <u>965</u>	RECORD Cased _____ in., _____ ft. Sand _____ Gas _____ Oil _____ Total Depth _____
	PRODUCTION 1st 24 hrs. Nat. _____ 1st 24 hrs. after shot _____ Gas _____ Cu. Ft. Dry Hole _____ Abandoned _____


Date 6/19 1918 P. Conley Scout

Map No. _____ Sec. 2 Twp. 29 R. 6Well No. 1 Frankson
oto oil Company _____

Contractor _____

NORTH

WEST

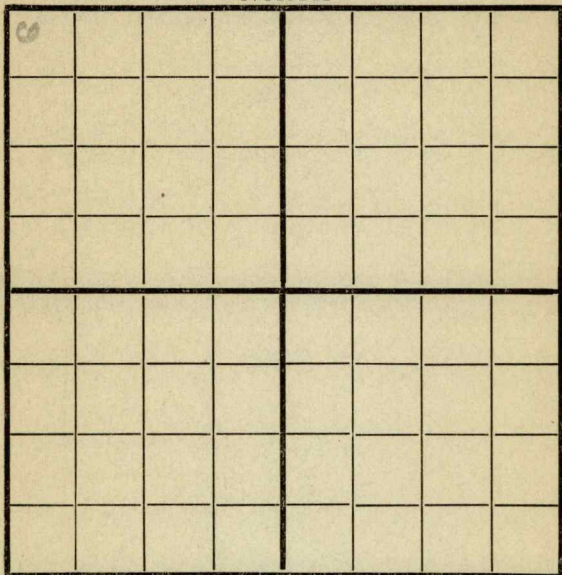

EAST

SOUTH

Location _____

Rig up _____

Drilling and Remarks:

*Shut down
for water
965*

RECORD

Cased _____ in., _____ ft.

Sand _____

Gas _____

Oil _____

Total Depth _____

PRODUCTION

1st 24 hrs. Nat. _____

1st 24 hrs. after shot _____

Gas _____ Cu. Ft.


Dry Hole _____

Abandoned _____

Date

6/56 191 *J. C. Cady* Scout

Map No. _____ Sec. 2 Twp. 29 R. 6
 Well No. 1 Thompson
oto 088 Company _____ Contractor _____

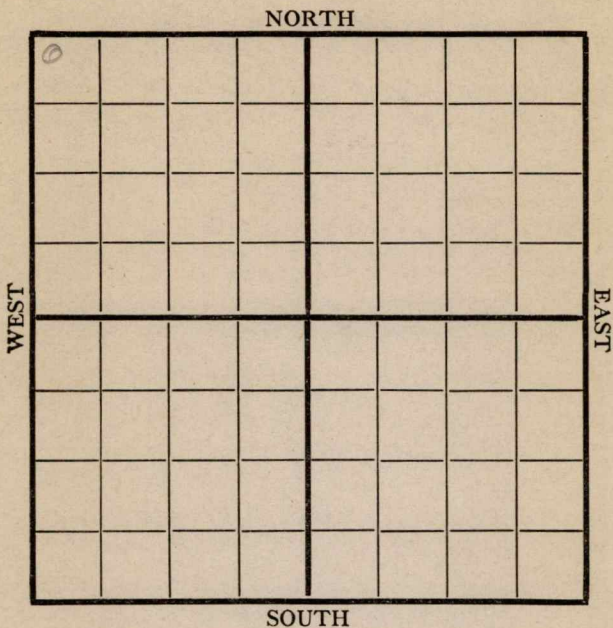

Location _____

Rig up _____

Drilling and Remarks:

RECORD

Cased _____ in., _____ ft.

Sand _____

Gas _____

Oil _____

Total Depth _____

PRODUCTION

1st 24 hrs. Nat. _____

1st 24 hrs. after shot _____

Gas _____ Cu. Ft.

Dry Hole _____

Abandoned _____

Date

7/3 1918 8 Carling Scout

Map No. _____ Sec. 2 Twp. 29 R. 6Well No. 1 Frankson_____
Company_____
Contractor

NORTH

WEST

EAST

SOUTH

Location _____

Rig up _____

Drilling and Remarks:

Under
Recovery
1600

RECORD

Cased _____ in., _____ ft.

Sand _____

Gas _____

Oil _____

Total Depth _____

PRODUCTION

1st 24 hrs. Nat. _____

1st 24 hrs. after shot _____

Gas _____ Cu. Ft.

Dry Hole _____

Abandoned _____

Date

7/10 J. Carley 191 Scout

Map No. _____ Sec. 2 Twp. 29 R. 6

Well No. 1 Frankson

_____ Company

_____ Contractor

NORTH

WEST

EAST

SOUTH

RECORD

Location _____

Cased _____ in., _____ ft.

Rig up _____

Sand _____

Drilling and Remarks:

Gas _____

Oil _____

Total Depth _____

PRODUCTION

1st 24 hrs. Nat. _____

1st 24 hrs. after shot _____

Gas _____ Cu. Ft.

Dry Hole _____

Abandoned _____

Date

7/17 191 Scout

Map No. _____ Sec. 2 Twp. 29 R. 6
Well No. Frankson
225 Company _____
Contractor _____

NORTH							
WEST	<u>0</u>						
SOUTH							
EAST							

Location _____

Rig up _____

Drilling and Remarks:

2000

RECORD

Cased _____ in., _____ ft.

Sand _____

Gas _____

Oil _____

Total Depth _____

PRODUCTION

1st 24 hrs. Nat. _____

1st 24 hrs. after shot _____

Gas _____ Cu. Ft.

Dry Hole _____

Abandoned _____

Date

7/24

191

J. C. Anderson

Scout

Map No. _____ Sec. 2 Twp. 29 R. 6
 Well No. 1 Frankson
Oto 006 Company _____ Contractor _____

NORTH							
WEST	0						
SOUTH							
EAST							

200 ~~324~~ x 200 ~~324~~ W L

RECORD

Location _____

Cased _____ in., _____ ft.

Rig up _____

Sand _____

Drilling and Remarks:

Gas _____

Oil _____

Total Depth _____

PRODUCTION

1st 24 hrs. Nat. _____

1st 24 hrs. after shot _____

Gas _____ Cu. Ft.

Dry Hole _____

Abandoned _____

Date

2/3/ 191 8 Conroy Scout _____


Map No. _____ Sec. 2 Twp. 29 R. 6Well No. 1 FranksonO to Oil _____ Company

_____ Contractor

NORTH

WEST

EAST

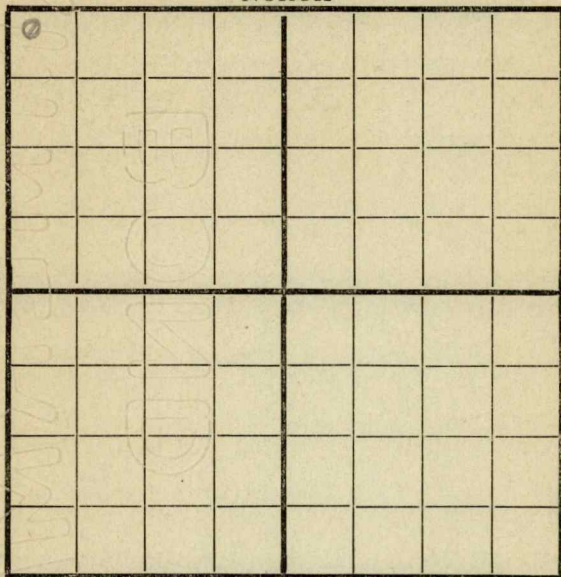

SOUTH

200 N 2 W

Location _____

Rig up _____

Drilling and Remarks:

2400

RECORD

Cased _____ in., _____ ft.

Sand _____

Gas _____

Oil _____

Total Depth _____

PRODUCTION

1st 24 hrs. Nat. _____

1st 24 hrs. after shot _____

Gas _____ Cu. Ft.

Dry Hole _____

Abandoned _____

Date

8/2

191

J. Cardiff

Scout

Map No. _____ Sec. 2 Twp. 29 R. 6Well No. 1 Frankson


Company _____

Contractor _____

NORTH

WEST

EAST

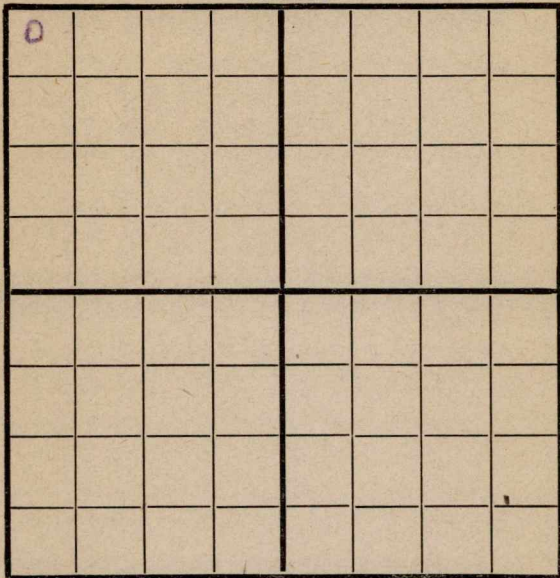

SOUTH

200 NW

Location _____

Rig up _____

Drilling and Remarks:

MR to
2440

RECORD

Cased _____ in., _____ ft.

Sand _____

Gas _____

Oil _____

Total Depth _____

PRODUCTION

1st 24 hrs. Nat. _____

1st 24 hrs. after shot _____

Gas _____ Cu. Ft.

Dry Hole _____

Abandoned _____

Date

8/14 J. C. C. C. 191 Scout


Map No. _____ Sec. 2 Twp. 29 R. 6Well No. 1 FranksonOil to Oil Company _____

Contractor _____

NORTH

WEST

EAST

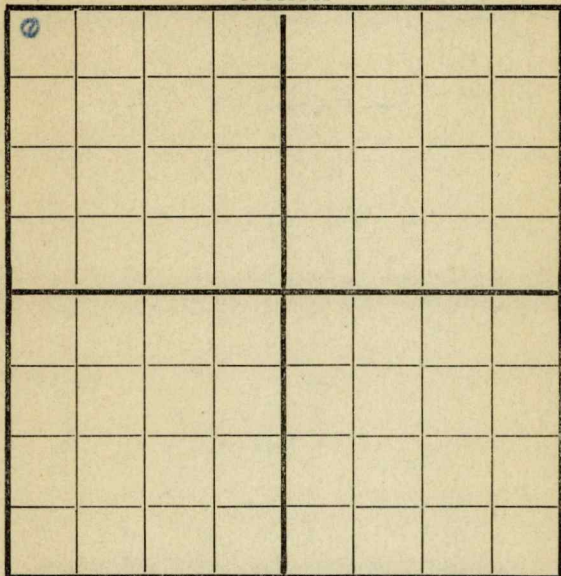

SOUTH

200' NTW

Location _____

Rig up _____

Drilling and Remarks:

RECORD

Cased _____ in., _____ ft.

Sand 2890-2910 showingGas oil

Oil _____

Total Depth _____

PRODUCTION

1st 24 hrs. Nat. _____

1st 24 hrs. after shot _____

Gas _____ Cu. Ft.

Dry Hole _____

Abandoned _____

Date


8/21 1918Cundiff

Scout

Map No. 1511 Sec. 2 Twp. 29 R. 6Well No. 1 Frankham0 to 075 Company _____

Contractor _____

NORTH

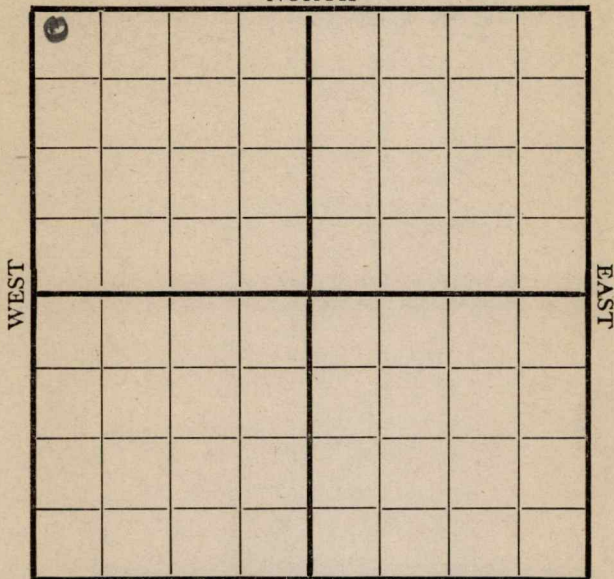

SOUTH

Location _____

Rig up _____

Drilling and Remarks:

Shot 120
 97- Shot bridge
 2916

RECORD

Cased _____ in., _____ ft.

Sand 2890-2916

Gas _____

Oil _____

Total Depth _____

PRODUCTION

1st 24 hrs. Nat. _____

1st 24 hrs. after shot _____

Gas _____ Cu. Ft.

Dry Hole _____

Abandoned _____

Date

8/28 1918 Candoff Scout

Map No. 1511 Sec. 2 Twp. 29 R. 6Well No. 1 Franklin0-10 07-8 Company _____

Contractor _____

NORTH

WEST

COMPLETED

EAST

COMPLETED

SOUTH

Location _____

Rig up _____

Drilling and Remarks:

Shot with
120 gts
Exp at 10
Bbls

RECORD

Cased _____ in., _____ ft.

Sand 2868-2893

Gas _____

Oil _____

Total Depth _____

PRODUCTION

1st 24 hrs. Nat. _____

1st 24 hrs. after shot _____

Gas _____ Cu. Ft.

Dry Hole _____

Abandoned _____


Date

9/5 1918 Candys Scout

Map No. 511 Sec. 2 Twp. 29 R. 6Well No. 1 FranksonOto oil CompanyWaymeyer ContractorLevee NORTH Kans.

WEST

EAST

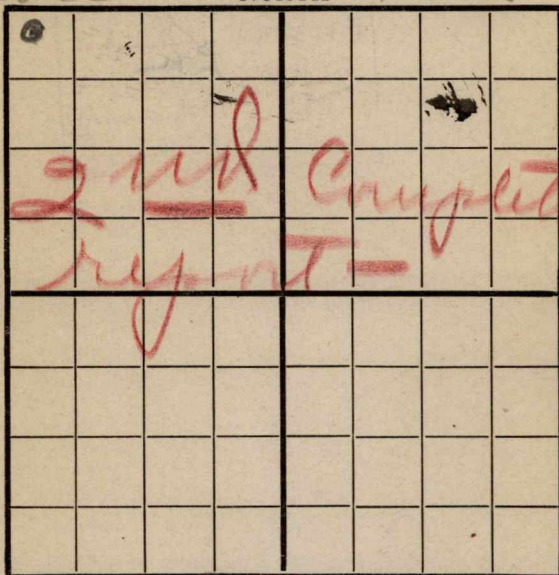

SOUTH

Location _____

Rig up _____

Drilling and Remarks:

I reported this well
good for 10 or 12 bbls
after standing two
weeks and cleaned
out good it has filled
up 2000 ft with oil and
is being put on pump
today - Looks like it may
be good for 50 or 60 bbls
oil is 40 gravity - will report production later

Date

RECORD

Cased _____ in., _____ ft.

Sand 2868-2904

Gas _____

Oil _____

Total Depth _____

PRODUCTION

1st 24 hrs. Nat. _____

1st 24 hrs. after shot _____

Gas _____ Cu. Ft.

Dry Hole _____

Abandoned _____

9/211918

Scout