

KANSAS


FORM 51 5M 10-41 PETROL

Russell

Section 14 Township 15 Range 14-W

Well No. #2 Kramer

Company Phillips

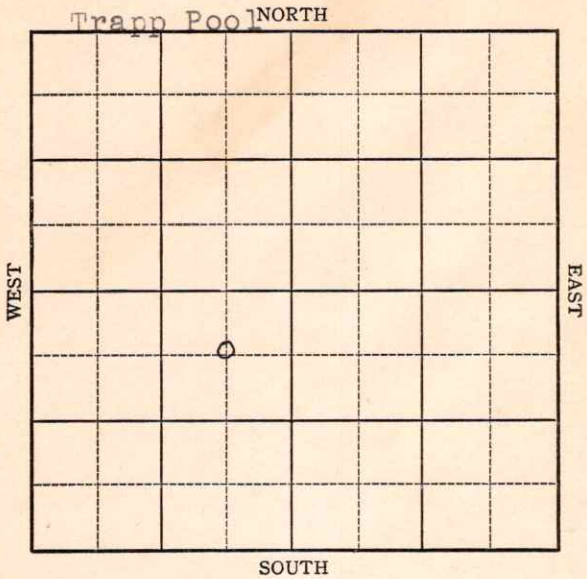

KANSAS

Russell

Sec. 14 Twp. 15 R. 14-W

Well No. #2 Kramer Farm

Phillips

Company

(Trapp Pool)


660 Ft. from N. Line

_____ Ft. from S. Line

660 Ft. from E. Line

_____ Ft. from W. Line

Elev. 1902

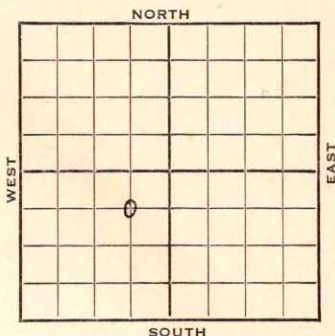

1942

REPORT

7/29

Location

8/5

"

8/12

8" @ 649 WOC

8/19

Drig. 3044'

8/27

Topeka 2807

Lans 3100

Arb 3344-45 TD 5" @ 3344 Rust

9/2

Arb. 3344

5" - 3344

T.D. 3349

Depth Pot. 6808

Max 3000

Gravity 38.3

COMPLETED

KANSAS

Russell

Map No. 73 Sec. 14 Twp. 15 R. 14WWell No. 2 KramerPhillips CompanyFIRST REPORT Contractor

C NE SW

SECTION PLAT

660 Ft. from N. Line

_____ Ft. from S. Line

660 Ft. from E. Line

_____ Ft. from W. Line

	o		

TRAPP POOL

Location XXX

Rig up _____

Drilling and Remarks:

RECORD

Cased _____ in., _____ ft.

Sand _____

Gas _____

Oil _____

Total Depth _____

PRODUCTION

1st 24 hrs. Nat. _____

1st 24 hrs. after shot _____

Gas _____ Cu. Ft.

Dry Hole _____

Abandoned _____

Date

JUL 29 1942

19

S. J. LEWIS

Scout

Russell

Map No. 73 Sec. 14 Twp. 15 R. 14W

Well No. 2 Kramer

Phillips Company

COMPLETED Contractor

C NE SW

SECTION PLAT

660 Ft. from N. Line

_____ Ft. from S. Line

660 Ft. from E. Line

_____ Ft. from W. Line

	D		

TRAPP POOL

Location _____

Rig up _____

Drilling and Remarks:

Cul & 3344
5" @ 3344
Dr. J. H. P. & 6808
Way 3000
383 Gr

RECORD

Cased _____ in., _____ ft.

Sand _____

Gas _____

Oil _____

Total Depth 3349

PRODUCTION

1st 24 hrs. Nat. _____

1st 24 hrs. after shot _____

Gas _____ Cu. Ft.

Dry Hole _____

Abandoned _____

Date

SEP 2 1942 19

S. J. LEWIS Scout