

KANSAS


FORM 51 5M 2-38 TPCO.

Rice

Section 30 Township 18 Range 7-W

Well No. 4 Ainsworth "A"

Company Continental

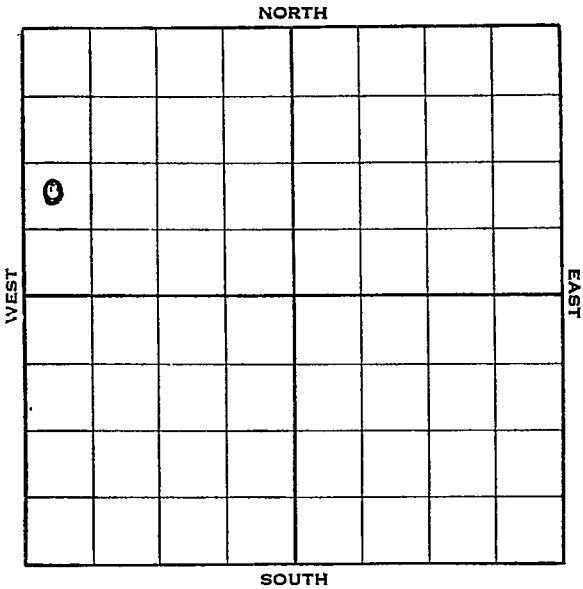

Map No. 45 Sec. 30 Twp. 18 R. 7WWell No. 4 Ainsworth "A"Continental CompanyContractor

FIRST REPORT

NW SW NW

 Ft. from N. Line990 Ft. from S. Line Ft. from E. Line330 Ft. from W. Line

SECTION PLAT

0	5		

Location Rig up

Drilling and Remarks:

BRR

RECORD

Cased in., ft.Sand Gas Oil Total Depth

PRODUCTION

1st 24 hrs. Nat. 1st 24 hrs. after shot Gas Cu. Ft.Dry Hole Abandoned

Date

MAY 4 1938 19 H. D. Hatfield Scout

Rice KANSAS

Map No. 45 Sec. 30 Twp. 18 R. 7WWell No. 4 Ainsworth "A"Continental Company

Contractor

ABANDONED

NW SW NW

 Ft. from N. Line990 Ft. from S. Line Ft. from E. Line330 Ft. from W. Line

SECTION PLAT

0			

Location Rig up

Drilling and Remarks:

*No shows**D & A*

RECORD

Cased in., ft.Sand *Arb 3198*Gas Oil Total Depth 3221

PRODUCTION

1st 24 hrs. Nat. 1st 24 hrs. after shot Gas Cu. Ft.Dry Hole Abandoned

Date

JUN 1 - 1938

19

H. D. Hatfield Scout