

KANSAS

Form 51—5M—7-40—Palace


Russell

Section 35 Township 15 Range 14-W

Well No. 7 Batt "A"

Company Shell

NORTH Trapp Pool

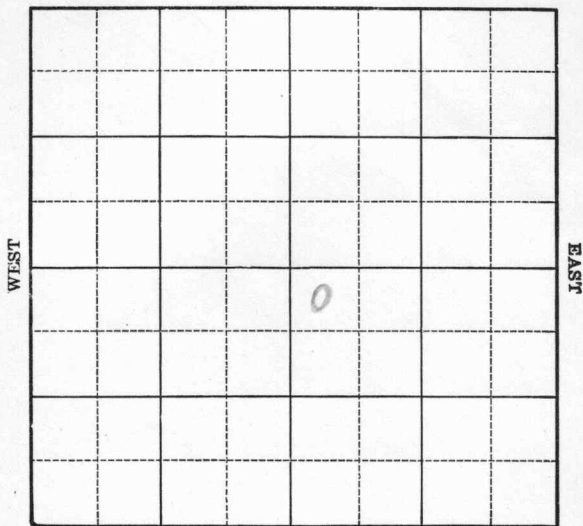

SOUTH

KANSAS

Russell

Sec. 35 Twp. 15 R. 14-WWell No. #7 Batt "A" FarmShell

Company

(Trapp)

330

Ft. from N. Line


Ft. from S. Line

Ft. from E. Line

330

Ft. from W. Line

Elev. 1893

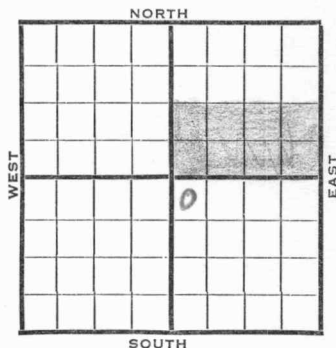

1941

REPORT

1/15

Location

1/23

8" - 620' Drlg. 965'

1/30

Drlg. 2831'

2/6

Lans. 3105' Arb. 3221-24' TD
4" - 3321'

2/13

T.D. 3328' 3000 acid.

Swab 184 oil in 4 hours.

2/19

Arb. 3321'

4" - 3321'

T.D. 3328'

3000 acid.

Echometer potential 1858 bbls.

No water.

COMPLETED

Map No. 73 Sec. 35 Twp. 15 R. 14WWell No. 7 Batt "A"

Shell

Company

FIRST REPORT


Contractor

NW SE

330 Ft. from N. Line Ft. from S. Line Ft. from E. Line330 Ft. from W. Line

TRAPP POOL

SECTION PLAT

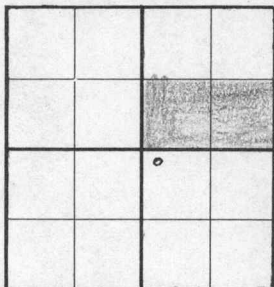Location XRig up

Drilling and Remarks:

RECORD

Cased in., ft.Sand Gas Oil Total Depth

PRODUCTION

1st 24 hrs. Nat. 1st 24 hrs. after shot Gas Cu. Ft.Dry Hole Abandoned

Date

JAN 15 1941

19

S. J. LEWIS

Scout

Map No. 73 Sec. 35 Twp. 15 R. 14WWell No. 7 Batt "A"Shell

Company

Contractor

COMPLETED

NW SE

330 Ft. from N. Line Ft. from S. Line Ft. from E. Line330 Ft. from W. Line**SECTION PLAT**

		o	

TRAPP POOL

Location Rig up

Drilling and Remarks:

*Cr X 3321**4 "C 3321**3000 feet**Echo P 8 1858**No water.***RECORD**Cased in., ft.Sand Gas Oil Total Depth 3328**PRODUCTION**1st 24 hrs. Nat. 1st 24 hrs. after shot Gas Cu. Ft.Dry Hole Abandoned

Date

FEB 19 1941 19

S. J. LEWIS Scout