


Section 30 Township 18 Range 7-W

Well Number #1-Ainsworth "A"

Company Continental et al

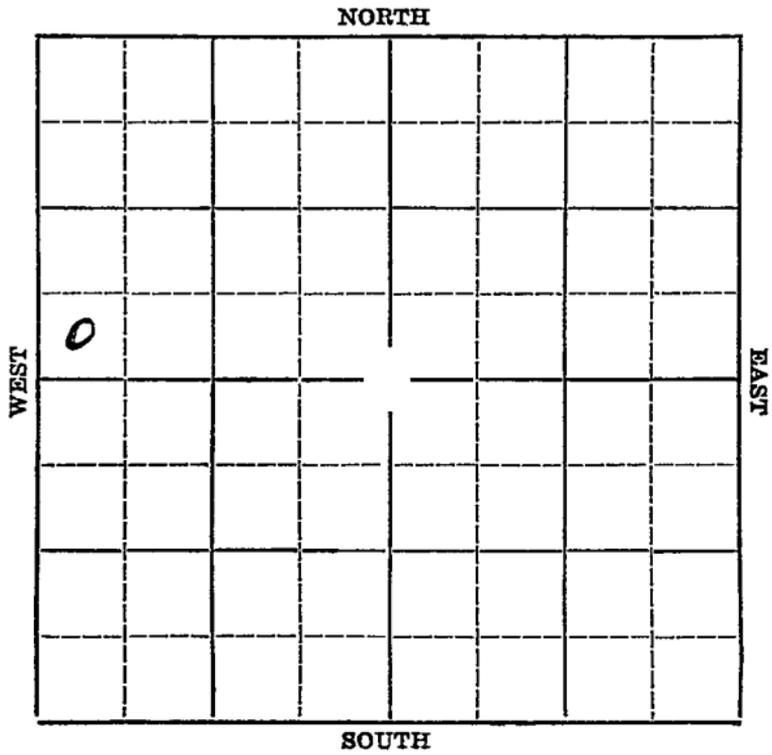

O. W. D. D



Sec. 30 Twp. 18 R. 7

Well No. #1 Ainsworth "A" Farm

Continental Oil et al Company


 Ft. from N. Line

330' Ft. from S. Line

 Ft. from E. Line

330' Ft. from W. Line

Elev. 1713

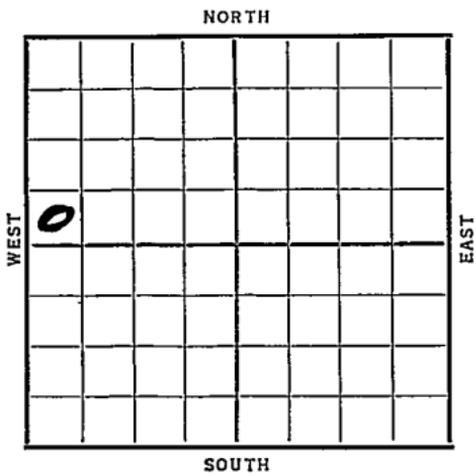

DATE	REPORT
8/19	Rig on ground.
8/27	12 $\frac{1}{2}$ " @ 191'. Waiting on cement.
9/3	Drlg. 2505'.
9/10	Siliceous 3153'. Set 7". TD 3155 Rigging up standard tools.
9/18	Drlg. 3194'. 1750' of oil in hole
9/24	TD 3207'. Clean out.
10/1	Run tubing.
10/8	4000 gallons of acid. Swab 116 oil and 70 water in 5 hours.
10/15	Shut down.
10/22	T.D. 3239' will plug back.
10/29	TD 3241'. PB 3212'. testing.
11/6	P. B. 3103'
11/12	----
11/19	T. D. 3180 run tubing.
11/27	T. D. 3180'. 4000 acid. making all water. Plugging back.
12/3	---
12/10	Shut down.

OVER



1936

12/17 Shut down.

12/24 " " 12/29--

1937

1/7 " "

1/14 " "

1/21 " "

1/27 --
T. D. 3241
D. & A.

ABANDONED

1938 O. W. D. D

1/12 RUST to deepen.

1/20 " " "

1/28 T.D. 3200' C.O.

2/4 2000 acid. No help.
Will deepen for S.W.D.

2/11 T.D. 3250'. Cement cave.

2/18 Drlg. cement.

2/26 " "

3/4 5" @ 3246'. Drlg. 3257'.

3/11 Drlg. 3404'.

3/18 5" @ 3358'. T.D. 3424'. RUST.

3/25 Drlg. 3475' for S.W.D. "

4/1 TD 3615' fsg.

4/8 Drlg. 3748' in sand.

4/15 T.D. 3925' in sand.

Testing input.

OVER



1938

4/20 5" @ 3358'.

Sand ?

T.D. 3925'.

Salt water disposal:

Input:

410 bbls. by vacuum in 1/2 hour.

Salt water disposal:

ABANDONED

Map No. 45 Sec. 30 Twp. 18 R. 2WWell No. 1 Ainsworth "A"Continental & Co Company

Contractor

SECTION PLAT

0			

_____ Ft. from N. Line

230 Ft. from S. Line

_____ Ft. from E. Line

330 Ft. from W. Line

FIRST REPORT

Location _____

Rig up _____

Drilling and Remarks:

ROG

RECORD

Cased _____ in., _____ ft.

Sand _____

Gas _____

Oil _____

Total Depth _____

PRODUCTION

1st 24 hrs. Nat. _____

1st 24 hrs. after shot _____

Gas _____ Cu. Ft.

Dry Hole _____

Abandoned _____

Date

AUG 19 1936 19S. J. LEWIS
Scout

Map No. 45 Sec. 30 Twp. 18 R. 7W

Well No. 1 S. Gainsworth "B"

Continental & Co Company

Contractor

SECTION PLAT

0			

_____ Ft. from N. Line

330 Ft. from S. Line

_____ Ft. from E. Line

330 Ft. from W. Line

ABANDONED

Location _____

Rig up _____

Drilling and Remarks:

Sil 3153

DVA

RECORD

Cased _____ in., _____ ft.

Sand _____

Gas _____

Oil _____

Total Depth 3241

PRODUCTION

1st 24 hrs. Nat. _____

1st 24 hrs. after shot _____

Gas _____ Cu. Ft.

Dry Hole _____

Abandoned _____

Date

JAN 27 1937 19

S. J. LEWIS

Scout

Map No. 45 Sec. 30 Twp. 18 R. 7WWell No. 1 Ainsworth ("A")Continental Company

Contractor

COMPLETED

SW NW

_____ Ft. from N. Line

330 Ft. from S. Line

_____ Ft. from E. Line

330 Ft. from W. Line

SECTION PLAT

0			

OWDD

Location _____

Rig up _____

Drilling and Remarks:

5211 wtr disposalinput:410 bbls byVacuum in 1/2 hrRECORD 3358Cased 5 in. 3246 ft.Sand ?

Gas _____

Oil _____

Total Depth 3925

PRODUCTION

1st 24 hrs. Nat. _____

1st 24 hrs. after shot _____

Gas _____ Cu. Ft.

Dry Hole _____

Abandoned _____

Date

APR 20 1938 19

H. D. Hatfield

Scout