


Section.....30.....Township.....18.....Range...7W.....

Well Number.....2 S. Ainsworth "A".....

Company.....Continental.....

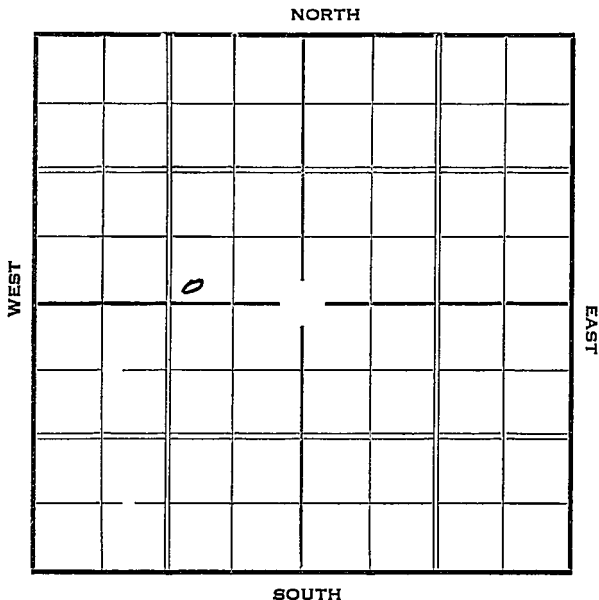

Sec. 30 Twp. 18 R. 7-W

Well No. #2 S. Ainsworth "A" Farm

Continental Company


 Ft. from N. Line

330 Ft. from S. Line

990 Ft. from E. Line

 Ft. from W. Line

Elev. 1721

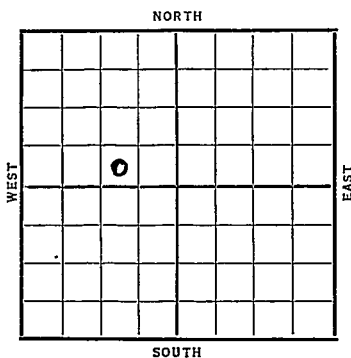

| Date | REPORT |
|------|--|
| 1/13 | Location |
| 1/21 | Rigging up |
| 1/28 | 12" @ 184'. WOC. |
| 2/4 | Drlg. 2980 |
| 2/11 | Sil 3179', 7" @ 3180' T.D. 3185 WOC |
| 2/19 | TD 3186! Swabb 20 bbls per hr. |
| 2/26 | Pump 425'. bbls. 17 hrs. |
| | |
| | |
| 3/3 | Sil. 3179'. |
| | T. D. 3188'. |
| | 1000 acid. |
| | Potential 1023. |
| | COMPLETED |
| | |
| | |
| | |
| | |
| | |

Map No. 45 Sec. 30 Twp. 18 R. 7W

Well No. 2 S. Pears with "C"

Continental Company

Contractor

SECTION PLAT

| | | | |
|--|---|--|--|
| | | | |
| | | | |
| | 0 | | |
| | | | |
| | | | |

_____ Ft. from N. Line

330 Ft. from S. Line

990 Ft. from E. Line

_____ Ft. from W. Line

FIRST REPORT

Location ✓

Rig up _____

Drilling and Remarks:

RECORD

Cased _____ in., _____ ft.

Sand _____

Gas _____

Oil _____

Total Depth _____

PRODUCTION

1st 24 hrs. Nat. _____

1st 24 hrs. after shot _____

Gas _____ Cu. Ft.

Dry Hole _____

Abandoned _____

Date

JAN 13 1937 19

S. J LEWIS

Scout

