


Section 36 Township 15 Range 14-W

Well Number 1 Deiners


Company Coralena

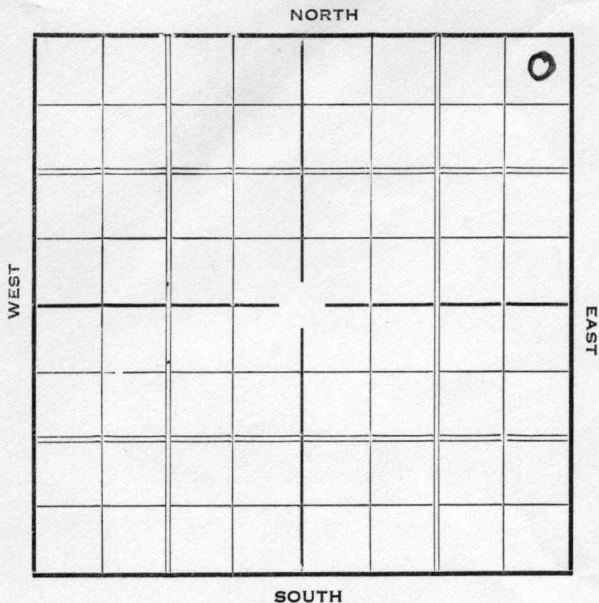

Sec. 36 Twp. 15 R. 14-W

Well No. #1 Deines Farm _____
Coralena Company _____

330 Ft. from N. Line
 _____ Ft. from S. Line
330 Ft. from E. Line
 _____ Ft. from W. Line

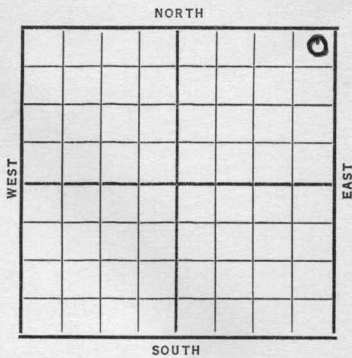

~~Elev. 1858~~

| Date | Elev. 1853 | REPORT |
|------|------------|-------------------------|
| 1937 | | |
| 5/19 | | Rig'n Rot. |
| 5/28 | | 12" @ 484'. Drlg. 975'. |
| 6/4 | | Drlg. 2905'. |
| 6/11 | | Sil. 3279'. 7" @ 3279'. |
| | | T.D. 3280'. RUST. |
| 6/19 | | T.D. 3282'. HFO, 2 hrs. |
| | | |
| 6/23 | | 7" @ 3279'. |
| | | Sil. 3279'. |
| | | T.D. 3282'. |
| | | Pot. 2680 bbls. Nat. |
| | | |
| | | COMPLETED |
| | | |
| | | |
| | | |
| | | |
| | | |
| | | |

Russell KANSAS

Map No. 73 Sec. 36 Twp. 15 R. 14^w

Well No. 1 - Deemes

Coralena Company

Contractor

COMPLETED

SECTION PLAT

330 Ft. from N. Line

_____ Ft. from S. Line

330 Ft. from E. Line

_____ Ft. from W. Line

| | | | |
|--|--|--|---|
| | | | 0 |
| | | | |
| | | | |
| | | | |

Location _____

Rig up _____

Drilling and Remarks:

Pat 2680

nat

RECORD

Cased 7 in., 3279 ft.

Sand 511, 3279

Gas _____

Oil _____

Total Depth 3282

PRODUCTION

1st 24 hrs. Nat. _____

1st 24 hrs. after shot _____

Gas _____ Cu. Ft.

Dry Hole _____

Abandoned _____

Date

JUN 23 1937 19 H. D. Hatfield Scout

KANSAS Russell

Map No. 73 Sec. 36 Twp. 15 R. 14^w

Well No. 1 - Deines

Coralenia Company

Contractor

FIRST REPORT

SECTION PLAT

530 Ft. from N. Line
____ Ft. from S. Line
330 Ft. from E. Line
____ Ft. from W. Line

| | | | |
|--|--|--|---|
| | | | 0 |
| | | | |
| | | | |
| | | | |

Location _____

Rig up _____

Drilling and Remarks:

Rign Rat

RECORD

Cased _____ in., _____ ft.
Sand _____
Gas _____
Oil _____
Total Depth _____

PRODUCTION

1st 24 hrs. Nat. _____
1st 24 hrs. after shot _____
Gas _____ Cu. Ft.
Dry Hole _____
Abandoned _____

Date

MAY 19 1937

H. D. Hatfield

19

Scout