

W-113010


FORM 51 5M PETROL

Rice

Section 30 Township 18 Range 7-W

Well No. #7 Sam Ainsworth "A"

Company Continental

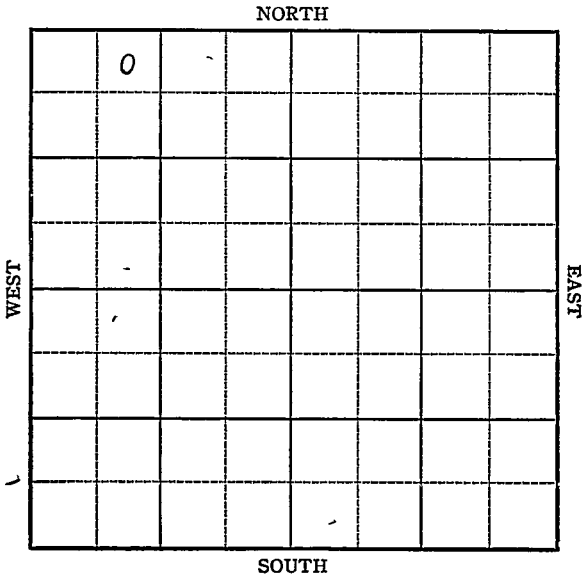

Sec. 30 Twp. 18 R. 7-W

Well No. #7 Sam Ainsworth "A" Farm

Continental Company


330 Ft. from N. Line

_____ Ft. from S. Line

_____ Ft. from E. Line

990 Ft. from W. Line

Elev. 1683

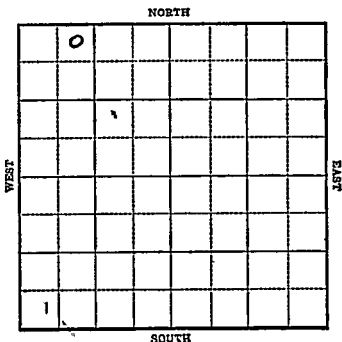

1943

R E P O R T

10/27

Rotary

11/3

10" @ 206'
Drig. 1701'

11/10

Lans 2740
SO 2768-75
Simp 3118
Arb 3125
T.D. 3140
7" @ 3126
Rust

11/17

TD 3142
2920' oil

12-1

7" @ 3126
Arb 3125
TD 3145
Echo Pot. 5590
Max 3000
Graivty 40.4

COMPLETED

KANSASMap No. 45 Sec. 30 Twp. 18 R. 7WWell No. 7 Sam Ainsworth "A"Continental Company**FIRST REPORT**

Contractor

NE NW NW

330 Ft. from N. Line

_____ Ft. from S. Line

_____ Ft. from E. Line

990 Ft. from W. Line**SECTION PLAT**

2			

Geneseo Pool

Location _____

Rig up _____

Drilling and Remarks:

Rotary

RECORD

Cased _____ in., _____ ft.

Sand _____

Gas _____

Oil _____

Total Depth _____

PRODUCTION

1st 24 hrs. Nat. _____

1st 24 hrs. after shot _____

Gas _____ Cu. Ft.

Dry Hole _____

Abandoned _____

Date

OCT 27 1943 19S. J. LEWIS Scout

Rice

KANSAS
 Map No. 7 Sec. 30 Twp. 18 R. 7W

Well No. 7 Sam Ainsworth "A"

Continental Company

COMPLETED Contractor

NE NW NW

SECTION PLAT

o			

330 Ft. from N. Line

_____ Ft. from S. Line

_____ Ft. from E. Line

990 Ft. from W. Line

Geneseo Pool

Location _____

Rig up _____

Drilling and Remarks:

See 8/3/25.

7" @ 3/26

Ecler P. 5590

W. of 3000

40 1/2

RECORD

Cased _____ in., _____ ft.

Sand _____

Gas _____

Oil _____

Total Depth 3145

PRODUCTION

1st 24 hrs. Nat. _____

1st 24 hrs. after shot _____

Gas _____ Cu. Ft.

Dry Hole _____

Abandoned _____

Date

DEC 1 1943

19

S. J. LEWIS Scout